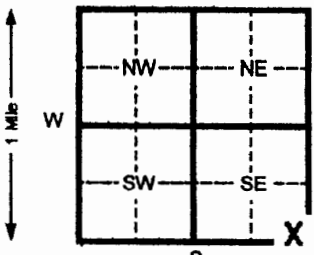


1] LOCATION OF WATER WELL:		Fraction	Section Number		Township Number		Range Number	
County: Sedgwick		SE 1/4 SE 1/4 SE 1/4	17		T 26 S		R 1	
Distance and direction from nearest town or city street address of well if located within city?								
Hills 66, 5403 North Broadway, Wichita, Ks								
2] WATER WELL OWNER: Lewis Williams								
RR#, St. Address, Box # : 15490 13th St.								
City, State, ZIP Code : Perry, Ks 66073								
Board of Agriculture, Division of Water Resources								
Application Number:								
3] LOCATE WELL'S LOCATION WITH AN "X" IN SECTION BOX:			4] DEPTH OF COMPLETED WELL 22 ft. ELEVATION: 1331.29					
			Depth(s) Groundwater Encountered 1 _____ ft. 2 _____ ft. 3 _____ ft.					
			WELL'S STATIC WATER LEVEL 15.14 ft. below land surface measured on mo/day/yr _____					
			Pump test data: Well water was _____ ft. after _____ hours pumping _____ gpm					
			Est. Yield _____ gpm: Well water was _____ ft. after _____ hours pumping _____ gpm					
			Bore Hole Diameter 6.25 in. to 22 ft. and _____ in. to _____ ft.					
			WELL WATER TO BE USED AS: 5 Public water supply 8 Air conditioning 11 Injection well					
			1 Domestic 3 Feed lot 6 Oil field water supply 9 Dewatering 12 Other (Specify below)					
			2 Irrigation 4 Industrial 7 Lawn and garden (domestic) 10 Monitoring well					
			Was a chemical/bacteriological sample submitted to Department? Yes _____ No X If yes, mo/day/yr sample was submitted _____					
			Water Well Disinfected? Yes _____ No X					
5] TYPE OF BLANK CASING USED:								
1 Steel 3 RMP (SR)			5 Wrought Iron 8 Concrete tile			CASING JOINTS: Glued _____ Clamped _____		
2 PVC 4 ABS			6 Asbestos-Cement 9 Other (specify below)			Welded _____		
			7 Fiberglass			Threaded X		
Blank casing diameter 4 in. to 7 ft., Dia _____ in. to _____ ft., Dia _____ in. to _____ ft.								
Casing height above land surface 0 in., weight 2.071 lbs./ft. Wall thickness or gauge No. .237								
TYPE OF SCREEN OR PERFORATION MATERIAL:								
1 Steel 3 Stainless steel 5 Fiberglass 8 RMP (SR) 10 Asbestos-cement								
2 Brass 4 Galvanized steel 6 Concrete tile 9 ABS 11 Other (specify) _____								
12 None used (open hole)								
SCREEN OR PERFORATION OPENINGS ARE:								
1 Continuous slot 3 Mill slot 5 Gauzed wrapped 8 Saw cut 11 None (open hole)								
2 Louvered shutter 4 Key punched 6 Wire wrapped 9 Drilled holes								
			7 Torch cut 10 Other (specify) _____					
SCREEN-PERFORATED INTERVALS: From 7 ft. to 22 ft. From _____ ft. to _____ ft.								
GRAVEL PACK INTERVALS: From 15 ft. to 22 ft. From _____ ft. to _____ ft.								
6] GROUT MATERIAL: 1 Neat cement 2 Cement grout 3 Bentonite 4 Other 10/20 graavel								
Grout Intervals From 1 ft. to 6 ft. From 6 ft. to 15 ft. From _____ ft. to _____ ft.								
What is the nearest source of possible contamination:								
1 Septic tank 4 Lateral lines 7 Pit privy 10 Livestock pens 14 Abandoned water well								
2 Sewer lines 5 Cess pool 8 Sewage lagoon 11 Fuel storage 15 Oil well/ Gas well								
3 Watertight sewer lines 6 Seepage pit 9 Feedyard 12 Fertilizer storage 16 Other (specify below)								
			13 Insecticide storage			Contaminated site		
Direction from well? _____ How many feet? _____								
7] CONTRACTOR'S OR LANDOWNER'S CERTIFICATION: This water well was (1) constructed, (2) reconstructed, or (3) plugged under my jurisdiction and was completed on (mo/day/yr) 60805 and this record is true to the best of my knowledge and belief. Kansas								
Water Well Contractor's License No. 554 This Water Well Record was completed on (mo/day/yr) 9-9-05								
under the business name of Woofter Pump & Well Inc. by (signature) _____								
INSTRUCTIONS: Please fill in blanks and circle the correct answers. Send three copies to Kansas Department of Health and Environment, Bureau of Water, 1000 S.W. Jackson St., Ste. 420, Topeka, Kansas 66612-1387. Telephone: 913-296-5545. Send one to WATER WELL OWNER and retain one for your records.								

OFFICE USE ONLY

1

加

SEC