WATER WELL RECORD Form WWC-5 KSA 82a-1212 ID No. AS-3

1 LOCATION OF WATER WELL:	Fraction	Section Number	Township Number	Range Number
County: Sedgwick	NW ¼ NW ¼ NW ¼	21	T 26 S	R 1 E/W

Distance and direction from nearest town or city street address of well if located within city?
Wally's Auto, 5360 N. Broadway, Wichita, Ks

2 WATER WELL OWNER: Roseann Harpster
RR#, St. Address, Box # : 5650 N. Broadway
City, State, ZIP Code : Wichita, Ks

Board of Agriculture, Division of Water Resources
Application Number:

3 LOCATE WELL'S LOCATON WITH AN "X" IN SECTION BOX:

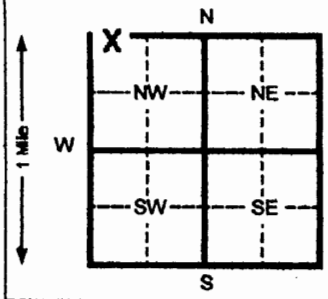

4 DEPTH OF COMPLETED WELL 27 ft. ELEVATION: 1330.57

Depth(s) Groundwater Encountered 1 ____ ft. 2 ____ ft. 3 ____ ft.

WELL'S STATIC WATER LEVEL ____ ft. below land surface measured on mo/day/yr ____

Pump test data: Well water was ____ ft. after ____ hours pumping ____ gpm

Est. Yield ____ gpm: Well water was ____ ft. after ____ hours pumping ____ gpm

Bore Hole Diameter 4.25 in. to 27 ft. and ____ in. to ____ ft.

WELL WATER TO BE USED AS: 5 Public water supply 8 Air conditioning 11 Injection well
1 Domestic 3 Feed lot 6 Oil field water supply 9 Dewatering 12 Other (Specify below)
2 Irrigation 4 Industrial 7 Lawn and garden (domestic) [10] Monitoring well Air Sparge

Was a chemical/bacteriological sample submitted to Department? Yes ____ No X ____ If yes, mo/day/yr sample was submitted ____ Water Well Disinfected? Yes ____ No ____

5 TYPE OF BLANK CASING USED: 5 Wrought iron 8 Concrete tile CASING JOINTS: Glued ____ Clamped ____
1 Steel 3 RMP (SR) 6 Asbestos-Cement 9 Other (specify below) Welded ____
[2] PVC 4 ABS 7 Fiberglass Threaded X

Blank casing diameter 2 in. to 25 ft., Dia ____ in. to ____ ft., Dia ____ in. to ____ ft.

Casing height above land surface 0 in., weight .716 lbs./ft. Wall thickness or gauge No. .154

TYPE OF SCREEN OR PERFORATION MATERIAL: [7] PVC 10 Asbestos-cement
1 Steel 3 Stainless steel 5 Fiberglass 8 RMP (SR) 11 Other (specify) ____
2 Brass 4 Galvanized steel 6 Concrete tile 9 ABS 12 None used (open hole)

SCREEN OR PERFORATION OPENINGS ARE: 5 Gauzed wrapped [8] Saw cut 11 None (open hole)
1 Continuous slot 3 Mill slot 6 Wire wrapped 9 Drilled holes
2 Louvered shutter 4 Key punched 7 Torch cut 10 Other (specify) ____

SCREEN-PERFORATED INTERVALS: From 25 ft. to 27 ft. From ____ ft. to ____ ft.
From ____ ft. to ____ ft. From ____ ft. to ____ ft.

GRAVEL PACK INTERVALS: From 22 ft. to 27 ft. From ____ ft. to ____ ft.
From ____ ft. to ____ ft. From ____ ft. to ____ ft.

6 GROUT MATERIAL: 1 Neat cement 2 Cement grout [3 Bentonite] 4 Other Bentonite Pellets

Grout Intervals From 2 ft. to 17 ft. From 17 ft. to 22 ft. From ____ ft. to ____ ft.

What is the nearest source of possible contamination: 10 Livestock pens 14 Abandoned water well
1 Septic tank 4 Lateral lines 7 Pit privy 11 Fuel storage 15 Oil well/ Gas well
2 Sewer lines 5 Cess pool 8 Sewage lagoon 12 Fertilizer storage 16 Other (specify below)
3 Watertight sewer lines 6 Seepage pit 9 Feedyard 13 Insecticide storage Contaminated site

Direction from well? How many feet?

FROM	TO	CODE	LITHOLOGIC LOG	FROM	TO	PLUGGING INTERVALS
0	3		fill clay			
3	14		Fill sand			
14	27		Fine to very fine grained sand			
27			weathered shale			

7 CONTRACTOR'S OR LANDOWNER'S CERTIFICATION: This water well was (1) constructed, (2) reconstructed, or (3) plugged under my jurisdiction and was and this record is true to the best of my knowledge and belief. Kansas

Water Well Contractor's License No. 554 This Water Well Record was completed on (mo/day/yr) 9-9=05

under the business name of Woofter Pump & Well Inc. by (signature) Jay G Woofter

INSTRUCTIONS:. Please fill in blanks and circle the correct answers. Send three copies to Kansas Department of Health and Environment, Bureau of Water, 1000 S W Jackson St., Ste. 420, Topeka, Kansas 66612-1367. Telephone: 913-296-5545. Send one to WATER WELL OWNER and retain one for your records.

OFFICE USE ONLY T R SEC

Form provided by Forms-On-A-Disk, Inc. · Dallas, Texas · (214) 340-6620