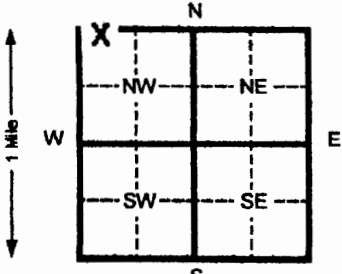


1 LOCATION OF WATER WELL:		Fraction	Section Number		Township Number		Range Number	
County: <b>Sedgwick</b>		NW ¼ NW ¼ NW ¼	<b>21</b>		T 26 S		R 1	
Distance and direction from nearest town or city street address of well if located within city?								
<b>Wally's Auto, 5360 N. Broadway, Wichita, Ks</b>								
2 WATER WELL OWNER: <b>Roseann Harpster</b>								
RR#, St. Address, Box #: <b>5650 N. Broadway</b>								
City, State, ZIP Code: <b>Wichita, Ks</b>								
Board of Agriculture, Division of Water Resources								
Application Number:								
3 LOCATE WELL'S LOCATION WITH AN "X" IN SECTION BOX:								
		4 DEPTH OF COMPLETED WELL <b>24</b> ft. ELEVATION: <b>1331.55</b>						
Depth(s) Groundwater Encountered 1 _____ ft. 2 _____ ft. 3 _____ ft.								
WELL'S STATIC WATER LEVEL <b>14.61</b> ft. below land surface measured on mo/day/yr								
Pump test data: Well water was _____ ft. after _____ hours pumping _____ gpm								
Est. Yield _____ gpm: Well water was <b>24</b> ft. after _____ hours pumping _____ gpm								
Bore Hole Diameter <b>4.25</b> in. to <b>20</b> ft. and _____ in. to _____ ft.								
WELL WATER TO BE USED AS: 5 Public water supply 8 Air conditioning 11 Injection well								
1 Domestic 3 Feed lot 6 Oil field water supply 9 Dewatering 12 Other (Specify below)								
2 Irrigation 4 Industrial 7 Lawn and garden (domestic) 10 Monitoring well								
Was a chemical/bacteriological sample submitted to Department? Yes _____ No <b>X</b> If yes, mo/day/yr sample was submitted _____								
Water Well Disinfected? Yes _____ No <b>X</b>								
5 TYPE OF BLANK CASING USED:								
1 Steel 3 RMP (SR) 5 Wrought iron 8 Concrete tile CASING JOINTS: Glued _____ Clamped _____								
2 PVC 4 ABS 6 Asbestos-Cement 9 Other (specify below) Welded _____								
7 Fiberglass _____ Threaded <b>X</b>								
Blank casing diameter <b>2</b> _____ <b>7.0</b> ft., Dia _____ in. to _____ ft., Dia _____ in. to _____ ft.								
Casing height above land surface <b>0</b> in., weight <b>.716</b> lbs./ft. Wall thickness or gauge No. <b>.154</b>								
TYPE OF SCREEN OR PERFORATION MATERIAL:								
1 Steel 3 Stainless steel 5 Fiberglass 7 PVC 10 Asbestos-cement								
2 Brass 4 Galvanized steel 6 Concrete tile 8 RMP (SR) 11 Other (specify) _____								
9 ABS 12 None used (open hole) _____								
SCREEN OR PERFORATION OPENINGS ARE:								
1 Continuous slot 3 Mill slot 5 Gauzed wrapped 8 Saw cut 11 None (open hole)								
2 Louvered shutter 4 Key punched 6 Wire wrapped 9 Drilled holes								
7 Torch cut 10 Other (specify) _____								
SCREEN-PERFORATED INTERVALS: From <b>7</b> ft. to <b>20</b> ft. From _____ ft. to _____ ft.								
From _____ ft. to _____ ft. From _____ ft. to _____ ft.								
GRAVEL PACK INTERVALS: From <b>14</b> ft. to <b>20</b> ft. From _____ ft. to _____ ft.								
From _____ ft. to _____ ft. From _____ ft. to _____ ft.								
6 GROUT MATERIAL: 1 Neat cement 2 Cement grout 3 Bentonite 4 Other <b>10/20 sand</b>								
Grout Intervals From <b>1</b> ft. to <b>8</b> ft. From <b>8</b> ft. to <b>14</b> ft. From _____ ft. to _____ ft.								
What is the nearest source of possible contamination:								
1 Septic tank 4 Lateral lines 7 Pit privy 10 Livestock pens 14 Abandoned water well								
2 Sewer lines 5 Cess pool 8 Sewage lagoon 11 Fuel storage 15 Oil well/ Gas well								
3 Watertight sewer lines 6 Seepage pit 9 Feedyard 12 Fertilizer storage 16 Other (specify below) <b>Contaminated site</b>								
13 Insecticide storage								
Direction from well? _____ How many feet? _____								
FROM TO CODE LITHOLOGIC LOG FROM TO PLUGGING INTERVALS								
<b>0 .5</b> <b>Cement</b>								
<b>.5 7.5</b> <b>Clay, stiff</b>								
<b>7.5 15</b> <b>Very fine grained silty sand,</b>								
<b>15 19.5</b> <b>Coarser mixed sand</b>								
<b>19.5 24</b> <b>Mixed sand &amp; gravel</b>								
7 CONTRACTOR'S OR LANDOWNER'S CERTIFICATION: This water well was (1) <u>constructed</u> , (2) reconstructed, or (3) plugged under my jurisdiction and was _____								
4-12=05 and this record is true to the best of my knowledge and belief. Kansas								
Water Well Contractor's License No. <b>554</b> This Water Well Record was completed on (mo/day/yr) <b>9-9=05</b>								
under the business name of <b>Woolter Pump &amp; Well Inc.</b> by (signature) _____								
INSTRUCTIONS: Please fill in blanks and circle the correct answers. Send three copies to Kansas Department of Health and Environment, Bureau of Water, 1000 S W Jackson St., Ste. 420, Topeka, Kansas 66612-1387. Telephone: 813-296-5545. Send one to WATER WELL OWNER and retain one for your records.								

OFFICE USE ONLY

1


SEC