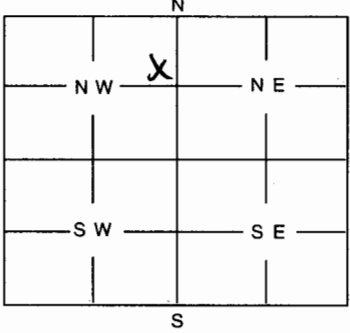


1	LOCATION OF WATER WELL: County: <u>Sedgwick</u>	Fraction <u>SE 1/4 NE 1/4 NW 1/4</u>	Section Number <u>33</u>	Township Number <u>26 S</u>	Range Number <u>1 E</u>																								
Distance and direction from nearest town or city street address of well if located within city? <u>801 E. 37th St. N. in Wichita, KS</u>																													
2	WATER WELL OWNER: <u>New Coleman Holdings</u> <u>55-IMP-3-D45</u> RR #, St. Address, Box #: <u>35 E. 62nd St.</u> City, State, ZIP Code : <u>New York, NY 10021</u> Board of Agriculture, Division of Water Resources Application Number:																												
3	MARK WELL'S LOCATION WITH AN "X" IN SECTION BOX: <div style="text-align: center;">  </div>																												
4	DEPTH OF WELL <u>13</u> ft. WELL'S STATIC WATER LEVEL <u>N/A</u> ft. WELL WAS USED AS: <div style="display: flex; justify-content: space-between;"> <div> 1 Domestic 2 Irrigation 3 Feedlot 4 Industrial </div> <div> 5 Public Water Supply 6 Oil Field Water Supply 7 Domestic (Lawn & Garden) 8 Air Conditioning </div> <div> 9 <u>Dewatering</u> 10 <u>Monitoring Well</u> 11 Injection Well 12 Other </div> </div> Was a chemical / bacteriological sample submitted to Department? Yes No <u>X</u> If yes, mo/day/yr sample was submitted Water Well Disinfected: Yes No <u>X</u>																												
5	TYPE OF BLANK CASING USED: 1 Steel 3 RMP (SR) 5 Wrought 7 Fiberglass 9 <u>Other (Specify below)</u> 2 PVC 4 ABS 6 Asbestos-Cement 8 Concrete Tile <u>Stainless Steel</u> Blank casing diameter <u>.25</u> in. Was casing pulled? Yes No <u>X</u> If yes, how much Casing height above or below land surface <u>-2</u> in.																												
6	GROUT PLUG MATERIAL: <u>1 Neat cement</u> 2 Cement grout 3 Bentonite 4 Other Grout Plug Intervals: From <u>.5</u> ft. to <u>13</u> ft., From ft. to ft., From to ft. What is the nearest source of possible contamination: <div style="display: flex; justify-content: space-between;"> <div> 1 Septic tank 2 <u>Sewer lines</u> 3 Watertight sewer lines 4 Lateral lines 5 Cess Pool </div> <div> 6 Seepage pit 7 Pit privy 8 Sewage lagoon 9 Feedyard 10 Livestock pens </div> <div> 11 Fuel storage 12 Fertilizer storage 13 Insecticide storage 14 Abandoned water well 15 Oil well/Gas well </div> <div> 16 Other (specify below) </div> </div> Direction from well? <u>South</u> How many feet? <u>10</u>																												
<table border="1" style="width:100%; border-collapse: collapse;"> <thead> <tr> <th style="width:10%;">FROM</th> <th style="width:10%;">TO</th> <th style="width:80%;">PLUGGING MATERIALS</th> </tr> </thead> <tbody> <tr> <td><u>.5</u></td> <td><u>13</u></td> <td><u>Portland Cement</u></td> </tr> <tr> <td><u>.5</u></td> <td><u>6.5</u></td> <td><u>Portland Cement</u></td> </tr> <tr><td> </td><td> </td><td> </td></tr> <tr><td> </td><td> </td><td> </td></tr> <tr><td> </td><td> </td><td> </td></tr> <tr><td> </td><td> </td><td> </td></tr> <tr><td> </td><td> </td><td> </td></tr> </tbody> </table>						FROM	TO	PLUGGING MATERIALS	<u>.5</u>	<u>13</u>	<u>Portland Cement</u>	<u>.5</u>	<u>6.5</u>	<u>Portland Cement</u>															
FROM	TO	PLUGGING MATERIALS																											
<u>.5</u>	<u>13</u>	<u>Portland Cement</u>																											
<u>.5</u>	<u>6.5</u>	<u>Portland Cement</u>																											
7	CONTRACTOR'S OR LANDOWNER'S CERTIFICATION: This water well was plugged under my jurisdiction and was completed on (mo/day/year) <u>6/21/06</u> and this record is true to the best of my knowledge and belief. Kansas Water Well Contractor's License No. <u>676</u> This Water Well Record was completed on (mo/day/year) <u>7/12/06</u> under the business name of <u>Whitetail Drilling, LLC</u> by (signature) <u>And. Bann</u>																												
INSTRUCTIONS: Use typewriter or ball point pen. <u>Please press firmly</u> and <u>print</u> clearly. Please fill in blanks, underline or circle the correct answers. Send top three copies to Kansas Department of Health and Environment, Bureau of Water, Topeka, Kansas 66620-0001. Telephone: 785/296-3565. Send one to Water Well Owner and retain one for your records.																													