


1	LOCATION OF WATER WELL:	Fraction	Section Number	Township Number	Range Number
County:	<i>Sedgewick</i>	<i>SW 1/4 NE 1/4 NW 1/4</i>	<i>33</i>	T <i>26</i> S	R <i>1</i> <i>EAN</i>

Distance and direction from nearest town or city street address of well if located within city?
3600 N Santa Fe

2	WATER WELL OWNER: LOVE BOP COMPANY, INC.	
RR#, St. Address, Box #	: Jim Schmidt	Board of Agriculture, Division of Water Resources
City, State, ZIP Code	: P.O. Box 546 Wichita, KS 67201	Application Number:

3 LOCATE WELL'S LOCATION WITH AN "X" IN SECTION BOX 4 DEPTH OF COMPLETED WELL 22 ft. ELEVATION: 1319.58
 5 12/5

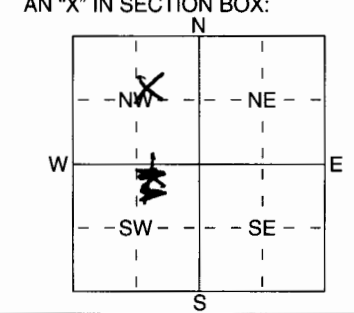

Depth(s) Groundwater Encountered 1 21.5 ft. 2 _____ ft. 3 _____ ft.
WELL'S STATIC WATER LEVEL NM ft. below land surface measured on mo/day/yr NM
Pump test data: Well water was _____ ft. after _____ hours pumping _____ gpm
Est. Yield _____ gpm: Well water was _____ ft. after _____ hours pumping _____ gpm
WELL WATER TO BE USED AS: 5 Public water supply 8 Air conditioning 11 Injection well
1 Domestic 3 Feedlot 6 Oil field water supply 9 Dewatering 12 Other (Specify below)
2 Irrigation 4 Industrial 7 Domestic (lawn & garden) 10 Monitoring well Soft Vapor Extract
Was a chemical/bacteriological sample submitted to Department? Yes _____ No X; If yes, mo/day/yr sample was submitted
Water Well Disinfected? Yes _____ No (X)

5	TYPE OF BLANK CASING USED:		5 Wrought iron	8 Concrete tile	CASING JOINTS: Glued Clamped Welded Threaded X
	1 Steel	3 RMP (SR)	6 Asbestos-Cement	9 Other (specify below)	
	<u>PVC</u>	4 ABS	7 Fiberglass	

Blank casing diameter 4 in. to 20 ft., Dia in. to ft., Dia in. to ft.
Casing height above land surface -8.40 in., weight lbs./ft. Wall thickness or gauge No. Sch 40 API C

TYPE OF SCREEN OR PERFORATION MATERIAL:

1 Steel	3 Stainless Steel	5 Fiberglass	7 PVC	10 Asbestos-Cement
2 Brass	4 Galvanized Steel	6 Concrete tile	8 RMP (SR)	11 Other (Specify)
			9 ABS	12 None used (open hole)

SCREEN OR PERFORATION OPENINGS ARE:

1 Continuous slot	8 Mill slot	5 Gauzed wrapped	8 Saw cut	11 None (open hole)
2 Louvered shutter	4 Key punched	6 Wire wrapped	9 Drilled holes	
		7 Torch cut	10 Other (specify)	ft.

SCREEN-PERFORATED INTERVALS: From 7 ft. to 20 ft., From _____ ft. to _____ ft.
From _____ ft. to _____ ft., From _____ ft. to _____ ft.

GRAVEL PACK INTERVALS: From 5 ft. to 22 ft., From _____ ft. to _____ ft.
From _____ ft. to _____ ft., From _____ ft. to _____ ft.

6 GROUT MATERIAL: 1 Neat cement 2 Cement grout 3 Bentonite 4 Other

Grout Intervals: From 1 ft to 5 ft From 1 ft to 1 ft From 1 ft to 1 ft

What is the nearest source of possible contamination:

1 Septic tank	4 Lateral lines	7 Pit privy	10 Livestock pens	14 Abandoned water well
2 Sewer lines	5 Cess pool	8 Sewage lagoon	11 Fuel storage	15 Oil well/Gas well
3 Watertight sewer lines	6 Seepage pit	9 Feedyard	12 Fertilizer storage	16 Other (specify below)
			13 Insecticide storage	<i>East Site</i>

Direction from well? _____ How many feet? _____

[illegible]

7] CONTRACTOR'S OR LANDOWNER'S CERTIFICATION: This water well was (1) constructed, (2) reconstructed, or (3) plugged under my jurisdiction and was completed on (mo/day/year) 5-24-06 and this record is true to the best of my knowledge and belief. Kansas Water Well Contractor's Licence No. 599 This Water Well Record was completed on (mo/day/yr) 8/2/06 under the business name of Corance Great Plains, Inc. by (signature) Michael E. Dwyer