MW-45 WATER WELL RECORD Form WWC-5 KSA 82a-1212 ID No. _____

1 LOCATION OF WATER WELL: County: **Sedgwick** | Fraction: **SW ¼ NW ¼ NE ¼** | Section Number: **27** | Township Number: T **26** S | Range Number: R **1** E/W

Distance and direction from nearest town or city street address of well if located within city?
2400 E 37th St, Wichita, KS, Lat: 37.76312 Long: 97.30900

2 WATER WELL OWNER: **Phillips 66 Company**
RR#, St. Address, Box # : **1234 Phillips 66 Bldg.**
City, State, ZIP Code : **Bartlesville, OK 74004**
Board of Agriculture, Division of Water Resources Application Number:

3 LOCATE WELL'S LOCATON WITH AN "X" IN SECTION BOX:

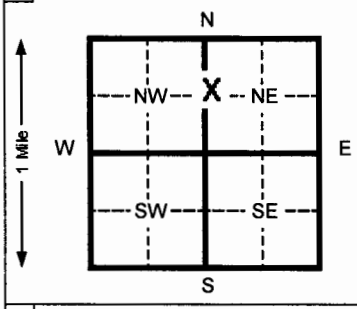

4 DEPTH OF COMPLETED WELL **19** ft. ELEVATION: **1,339.88 (ground surface)**
Depth(s) Groundwater Encountered 1 **Unknown** ft. 2 _____ ft. 3 _____ ft.
WELL'S STATIC WATER LEVEL **4.92** ft. below land surface measured on mo/day/yr **10/4/06**
Pump test data: Well water was **N/A** ft. after _____ hours pumping _____ gpm
Est. Yield **N/A** gpm: Well water was **N/A** ft. after _____ hours pumping _____ gpm
Bore Hole Diameter **8** in. to **19** ft. and _____ in. to _____ ft.
WELL WATER TO BE USED AS: 1 Domestic 2 Irrigation 3 Feed lot 4 Industrial 5 Public water supply 6 Oil field water supply 7 Lawn and garden (domestic) 8 Air conditioning 9 Dewatering 10 Monitoring well 11 Injection well 12 Other (Specify below)
Was a chemical/bacteriological sample submitted to Department? Yes _____ No **X** If yes, mo/day/yr sample was submitted
Water Well Disinfected? Yes _____ No **X**

5 TYPE OF BLANK CASING USED: 1 Steel 2 PVC 3 RMP (SR) 4 ABS 5 Wrought Iron 6 Asbestos-Cement 7 Fiberglass 8 Concrete tile 9 Other (specify below)
CASING JOINTS: Glued _____ Clamped _____ Welded _____ Threaded _____
Blank casing diameter **2** in. to **4** ft., Dia _____ in. to _____ ft., Dia _____ in. to _____ ft.
Casing height above land surface **31.08** in., weight **0.682** lbs./ft. Wall thickness or gauge No. **0.1875 in.**
TYPE OF SCREEN OR PERFORATION MATERIAL: 1 Steel 2 Brass 3 Stainless steel 4 Galvanized steel 5 Fiberglass 6 Concrete tile 7 PVC 8 RMP (SR) 9 ABS 10 Asbestos-cement 11 Other (specify) 12 None used (open hole)
SCREEN OR PERFORATION OPENINGS ARE: 1 Continuous slot 2 Louvered shutter 3 Mill slot 4 Key punched 5 Gauzed wrapped 6 Wire wrapped 7 Torch cut 8 Saw cut 9 Drilled holes 10 Other (specify) 11 None (open hole)
SCREEN-PERFORATED INTERVALS: From **4** ft. to **19** ft. From _____ ft. to _____ ft.
From _____ ft. to _____ ft. From _____ ft. to _____ ft.
GRAVEL PACK INTERVALS: From **3** ft. to **19** ft. From _____ ft. to _____ ft.
From _____ ft. to _____ ft. From _____ ft. to _____ ft.

6 GROUT MATERIAL: 1 Neat cement 2 Cement grout 3 Bentonite 4 Other _____
Grout Intervals From **1** ft. to **3** ft. From _____ ft. to _____ ft. From _____ ft. to _____ ft.
What is the nearest source of possible contamination:
1 Septic tank 2 Sewer lines 3 Watertight sewer lines 4 Lateral lines 5 Cess pool 6 Seepage pit 7 Pit privy 8 Sewage lagoon 9 Feedyard 10 Livestock pens 11 Fuel storage 12 Fertilizer storage 13 Insecticide storage 14 Abandoned water well 15 Oil well/ Gas well 16 Other (specify below)
Direction from well? **south** How many feet? **375**

FROM	TO	CODE	LITHOLOGIC LOG	FROM	TO	PLUGGING INTERVALS
0	10	03	low plasticity, silty clay			
10	19	05	brown, fine-medium sand			

7 CONTRACTOR'S OR LANDOWNER'S CERTIFICATION: This water well was (1) constructed, (2) reconstructed, or (3) plugged under my jurisdiction and was completed on (mo/day/yr) 9/28/06 and this record is true to the best of my knowledge and belief. Kansas Water Well Contractor's License No. 616 This Water Well Record was completed on (mo/day/yr) 11/28/06
under the business name of Thiele Geotech, Inc. by (signature) D. Thiele

INSTRUCTIONS:. Please fill in blanks and circle the correct answers. Send three copies to Kansas Department of Health and Environment, Bureau of Water, 1000 S W Jackson St., Ste. 420, Topeka, Kansas 66612-1367. Telephone: 913-296-5545. Send one to WATER WELL OWNER and retain one for your records.

OFFICE USE ONLY T R SEC

Form provided by Forms-On-A-Disk, Inc. · Dallas, Texas · (214) 340-9429