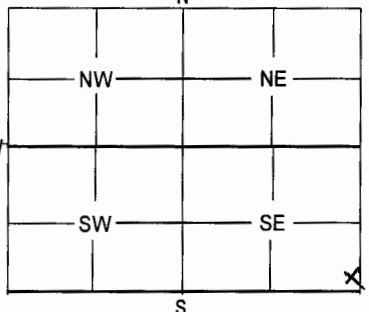


1 LOCATION OF WATER WELL:		Fraction	Section	Number	Township	Number	Range	Number																								
County: Sedgwick		SE 1/4 SE 1/4 SE 1/4	26		26		1	EN																								
Distance and direction from nearest town or city street address of well if located within city?																																
2 WATER WELL OWNER: Koch Industries																																
RR #, St. Address, Box # 4111 E. 37th Street North				Board of Agriculture, Division of Water Resources																												
City, State, ZIP Code Wichita, KS 67220				Application Number:																												
3 MARK WELL'S LOCATION WITH AN "X" IN SECTION BOX:			4 DEPTH OF WELL 30 ft.																													
			WELL'S STATIC WATER LEVEL 12.0 ft.																													
			WELL WAS USED AS:																													
			1 Domestic 2 Irrigation 3 Feedlot 4 Industrial 5 Public Water Supply 6 Oil Field Water Supply 7 Domestic (Lawn & Garden) 8 Air Conditioning 9 Dewatering 10 Monitoring Well 11 Injection Well 12 Other																													
			Was a chemical / bacteriological sample submitted to Department? Yes No X																													
			if yes, mo/day/yr sample was submitted																													
			Water Well Disinfected: Yes No X																													
5 TYPE OF BLANK CASING USED:																																
1 Steel 2 PVC 3 RMP (SR) 4 ABS 5 Wrought 6 Asbestos-Cement 7 Fiberglass 8 Concrete Tile 9 Other (Specify below)																																
Blank casing diameter 2 in. Was casing pulled? Yes X No If yes, how much All																																
Casing height above or below land surface 0 in.																																
6 GROUT PLUG MATERIAL: 1 Neat cement 2 Cement grout 3 Bentonite 4 Other																																
Grout Plug Intervals: From 30 ft. to 0 ft., From ft. to ft., From to ft.																																
What is the nearest source of possible contamination:																																
1 Septic tank 2 Sewer lines 3 Watertight sewer lines 4 Lateral lines 5 Cess pool 6 Seepage pit 7 Pit privy 8 Sewage lagoon 9 Feedyard 10 Livestock pens 11 Fuel storage 12 Fertilizer storage 13 Insecticide storage 14 Abandoned water well 15 Oil well/Gas well 16 Other (specify below)																																
Direction from well? 999 How many feet? 999																																
<table border="1"><thead><tr><th>FROM</th><th>TO</th><th>PLUGGING MATERIALS</th></tr></thead><tbody><tr><td>30</td><td>0</td><td>Bentonite Grout</td></tr><tr><td></td><td></td><td></td></tr><tr><td></td><td></td><td></td></tr><tr><td></td><td></td><td></td></tr><tr><td></td><td></td><td></td></tr><tr><td></td><td></td><td>MW-5</td></tr><tr><td></td><td></td><td></td></tr></tbody></table>									FROM	TO	PLUGGING MATERIALS	30	0	Bentonite Grout															MW-5			
FROM	TO	PLUGGING MATERIALS																														
30	0	Bentonite Grout																														
		MW-5																														
7 CONTRACTOR'S OF LANDOWNER'S CERTIFICATION: This water well was plugged under my jurisdiction and was completed on (mo/day/year) 12-22-06 and this record is true to the best of my knowledge and belief. Kansas Water Well Contractor's License No. 665 This Water Well Record was completed on (mo/day/year) 2-22-07 under the business name of Pratt Well Environmental																																
by (signature) [Signature]																																
INSTRUCTIONS: Use typewriter or ball point pen. Please press firmly and print clearly. Please fill in blanks, underline or circle the correct answers. Send top three copies to Kansas Department of Health and Environment, Bureau of Water, Geology Section, 1 000 SW Jackson St., Ste. 420, Topeka, Kansas 66612-1367. Telephone: 785/296-5522. Send one to Water Well Owner and retain one for your records.																																