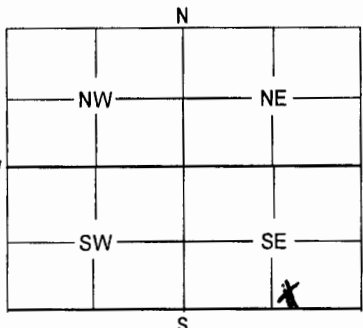


1	LOCATION OF WATER WELL:	Fraction	Section Number	Township Number	Range Number																											
	County: Sedgwick	SW 1/4 SE 1/4 SE 1/4	26	26	1 E/W																											
Distance and direction from nearest town or city street address of well if located within city?																																
4100 block of E. 37th St., Wichita, KS																																
2	WATER WELL OWNER: Koch Industries																															
	RR #, St. Address, Box # 4111 E. 37th St.		Board of Agriculture, Division of Water Resources																													
	City, State, ZIP Code Wichita, KS 67220		Application Number:																													
3	MARK WELL'S LOCATION WITH AN "X" IN SECTION BOX: <div style="text-align: center;">  </div>		4	DEPTH OF WELL 63.5 ft.																												
			WELL'S STATIC WATER LEVEL 28 ft.																													
			WELL WAS USED AS:																													
			<div style="display: flex; justify-content: space-between;"> <div> 1 Domestic 2 Irrigation 3 Feedlot 4 Industrial </div> <div> 5 Public Water Supply 6 Oil Field Water Supply 7 Domestic (Lawn & Garden) 8 Air Conditioning </div> <div> 9 Dewatering 10 Monitoring Well 11 Injection Well 12 Other </div> </div>																													
Was a chemical / bacteriological sample submitted to Department? Yes No X																																
if yes, mo/day/yr sample was submitted																																
Water Well Disinfected: Yes No X																																
5	TYPE OF BLANK CASING USED:																															
	1 Steel 3 RMP (SR) 5 Wrought 7 Fiberglass 9 Other (Specify below) 2 PVC 4 ABS 6 Asbestos-Cement 8 Concrete Tile																															
	Blank casing diameter 5 in. Was casing pulled? Yes X No If yes, how much 51'																															
	Casing height above or below land surface 0 in.																															
6	GROUT PLUG MATERIAL: 1 Neat cement 2 Cement grout 3 Bentonite 4 Other																															
	Grout Plug Intervals: From 62 ft. to 0 ft., From ft. to ft., From ft. to ft.																															
What is the nearest source of possible contamination:																																
<div style="display: flex; flex-wrap: wrap;"> <div style="width: 33%;">1 Septic tank</div> <div style="width: 33%;">6 Seepage pit</div> <div style="width: 33%;">11 Fuel storage</div> <div style="width: 33%;">16 Other (specify below)</div> <div style="width: 33%;">2 Sewer lines</div> <div style="width: 33%;">7 Pit privy</div> <div style="width: 33%;">12 Fertilizer storage</div> <div style="width: 33%;">13 Insecticide storage</div> <div style="width: 33%;">3 Watertight sewer lines</div> <div style="width: 33%;">8 Sewage lagoon</div> <div style="width: 33%;">14 Abandoned water well</div> <div style="width: 33%;">4 Lateral lines</div> <div style="width: 33%;">9 Feedyard</div> <div style="width: 33%;">15 Oil well/Gas well</div> <div style="width: 33%;">5 Cess pool</div> <div style="width: 33%;">10 Livestock pens</div> </div>																																
Direction from well? 999 How many feet? 999																																
<table border="1" style="width:100%; border-collapse: collapse;"> <thead> <tr> <th style="width:10%;">FROM</th> <th style="width:10%;">TO</th> <th style="width:80%;">PLUGGING MATERIALS</th> </tr> </thead> <tbody> <tr> <td>62</td> <td>0</td> <td>3/8 Bentonite chips</td> </tr> <tr><td> </td><td> </td><td> </td></tr> <tr><td> </td><td> </td><td> </td></tr> <tr><td> </td><td> </td><td> </td></tr> <tr><td> </td><td> </td><td> </td></tr> <tr><td> </td><td> </td><td> </td></tr> <tr><td> </td><td> </td><td> </td></tr> <tr><td> </td><td> </td><td> </td></tr> </tbody> </table>						FROM	TO	PLUGGING MATERIALS	62	0	3/8 Bentonite chips																					
FROM	TO	PLUGGING MATERIALS																														
62	0	3/8 Bentonite chips																														
7	CONTRACTOR'S OF LANDOWNER'S CERTIFICATION: This water well was plugged under my jurisdiction and was completed on (mo/day/year) 2-20-07 and this record is true to the best of my knowledge and belief. Kansas Water Well Contractor's License No. 665 This Water Well Record was completed on (mo/day/year) 3-12-07																															
	by (signature) <i>Steven E. Pratt</i> Pratt Well Environmental																															
INSTRUCTIONS: Use typewriter or ball point pen. Please press firmly and print clearly. Please fill in blanks, underline or circle the correct answers. Send top three copies to Kansas Department of Health and Environment, Bureau of Water, Geology Section, 1 000 SW Jackson St., Ste. 420, Topeka, Kansas 66612-1367. Telephone: 785/296-5522. Send one to Water Well Owner and retain one for your records.																																