

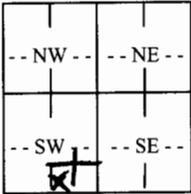
**WATER WELL RECORD**

**Form WWC-5**

Division of Water Resources; App. No.

**MW-24**

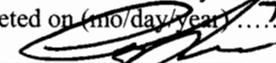
|   |   |   |                                  |                              |
|---|---|---|----------------------------------|------------------------------|
| <b>1 LOCATION OF WATER WELL:</b><br>County: <u>Sedgwick</u>   | Fraction<br><u>SW 1/4 SE 1/4 SW 1/4</u> | Section Number<br><u>27</u>   | Township Number<br><u>T 26 S</u> | Range Number<br><u>R 1 W</u> |
| Distance and direction from nearest town or city street address of well if located within city?<br><u>2100 E. 37th St. N. Wichita, KS</u>                       |   | Global Positioning Systems (decimal degrees, min. of 4 digits)<br>Latitude: <u>37 45 112</u><br>Longitude: <u>97 18 609</u> |                                  |                              |
| <b>2 WATER WELL OWNER:</b> <u>Coleman Company</u><br>RR#, St. Address, Box # : <u>3600 N. Hydraulic St.</u><br>City, State, ZIP Code : <u>Wichita, KS 67219</u> |   | Elevation: _____<br>Datum: _____<br>Data Collection Method: _____   |                                  |                              |

|  |  |
|--|--|
| <b>3 LOCATE WELL'S LOCATION WITH AN "X" IN SECTION BOX:</b><br>N<br>W<br>E<br>S  | <b>4 DEPTH OF COMPLETED WELL</b> ..... <u>27.0</u> ..... ft.   |
|  | Depth(s) Groundwater Encountered (1)..... ft. (2)..... ft. (3)..... ft.<br>WELL'S STATIC WATER LEVEL..... <u>6.49</u> ft. below land surface measured on mo/day/yr.....<br>Pump test data: Well water was.....ft. after..... hours pumping..... gpm<br>Est. Yield.....gpm: Well water was.....ft. after..... hours pumping..... gpm<br>WELL WATER TO BE USED AS: 5 Public water supply 8 Air conditioning 11 Injection well<br>1 Domestic 3 Feedlot 6 Oil field water supply 9 Dewatering 12 Other (Specify below)<br>2 Irrigation 4 Industrial 7 Domestic (lawn & garden) <u>10</u> Monitoring well ..... |
|  | Was a chemical/bacteriological sample submitted to Department? Yes ..... No <u>X</u> ..... If yes, mo/day/yr Sample was submitted..... Water well disinfected? Yes ..... No <u>X</u> .....   |

|  |   |  |
|--|---|--|
| <b>5 TYPE OF CASING USED:</b><br>1 Steel 3 RMP (SR) 6 Asbestos-Cement 9 Other (specify below)<br><u>2 PVC</u> 4 ABS 2" 7 Fiberglass  | 5 Wrought Iron 8 Concrete tile<br>6 Asbestos-Cement 9 Other (specify below)<br>7 Fiberglass   | CASING JOINTS: Glued..... Clamped.....<br>Welded.....<br>Threaded <u>X</u> ..... |
| Blank casing diameter ..... <u>2</u> in. to ..... ft., Diameter..... in. to ..... ft., Diameter ..... in. to ..... ft.<br>Casing height above land surface..... <u>Flash</u> in., Weight ..... lbs./ft. Wall thickness or gauge No. <u>sel. 40</u> | TYPE OF SCREEN OR PERFORATION MATERIAL:<br>1 Steel 3 Stainless Steel 5 Fiberglass <u>7 PVC</u> 9 ABS 11 Other (Specify) .....<br>2 Brass 4 Galvanized Steel 6 Concrete tile 8 RM (SR) 10 Asbestos-Cement 12 None used (open hole) |  |
| SCREEN OR PERFORATION OPENINGS ARE:<br>1 Continuous slot <u>3 Mill slot</u> 5 Gauzed wrapped 7 Torch cut 9 Drilled holes 11 None (open hole)<br>2 Louvered shutter 4 Key punched 6 Wire wrapped 8 Saw Cut 10 Other (specify) .....                 |   |  |
| SCREEN-PERFORATED INTERVALS: From..... <u>12</u> ft. to ..... <u>27</u> ft., From ..... ft. to ..... ft.<br>From..... ft. to ..... ft., From ..... ft. to ..... ft.  |   |  |
| GRAVEL PACK INTERVALS: From..... <u>9</u> ft. to ..... <u>27</u> ft., From ..... ft. to ..... ft.<br>From..... ft. to ..... ft., From ..... ft. to ..... ft.   |   |  |

|  |
|--|
| <b>6 GROUT MATERIAL:</b> 1 Neat cement <u>2</u> Cement grout <u>3</u> Bentonite 4 Other.....   |
| Grout Intervals: From..... <u>1</u> ft. to ..... <u>5</u> ft., From..... <u>5</u> ft. to ..... <u>9</u> ft., From ..... ft. to ..... ft.   |
| What is the nearest source of possible contamination:<br>1 Septic tank 4 Lateral lines 7 Pit privy 10 Livestock pens 13 Insecticide Storage 16 Other (specify below)<br>2 Sewer lines 5 Cess pool 8 Sewage lagoon <u>11</u> Fuel storage 14 Abandoned water well<br>3 Watertight sewer lines 6 Seepage pit 9 Feedyard 12 Fertilizer Storage 15 Oil well/gas well ..... |
| Direction from well? ..... How many feet? <u>3000</u>  |

| FROM | TO | LITHOLOGIC LOG        | FROM | TO | PLUGGING INTERVALS |
|------|----|-----------------------|------|----|--------------------|
|      |    | <u>See Boring Log</u> |      |    |                    |
|      |    |                       |      |    |                    |
|      |    |                       |      |    |                    |
**7 CONTRACTOR'S OR LANDOWNER'S CERTIFICATION:** This water well was 1 constructed, (2) reconstructed, or (3) plugged under my jurisdiction and was completed on (mo/day/year) 6-19-08 and this record is true to the best of my knowledge and belief. Kansas Water Well Contractor's License No. 608 This Water Well Record was completed on (mo/day/year) 7-25-08 under the business name of PSA Environmental by (signature) 

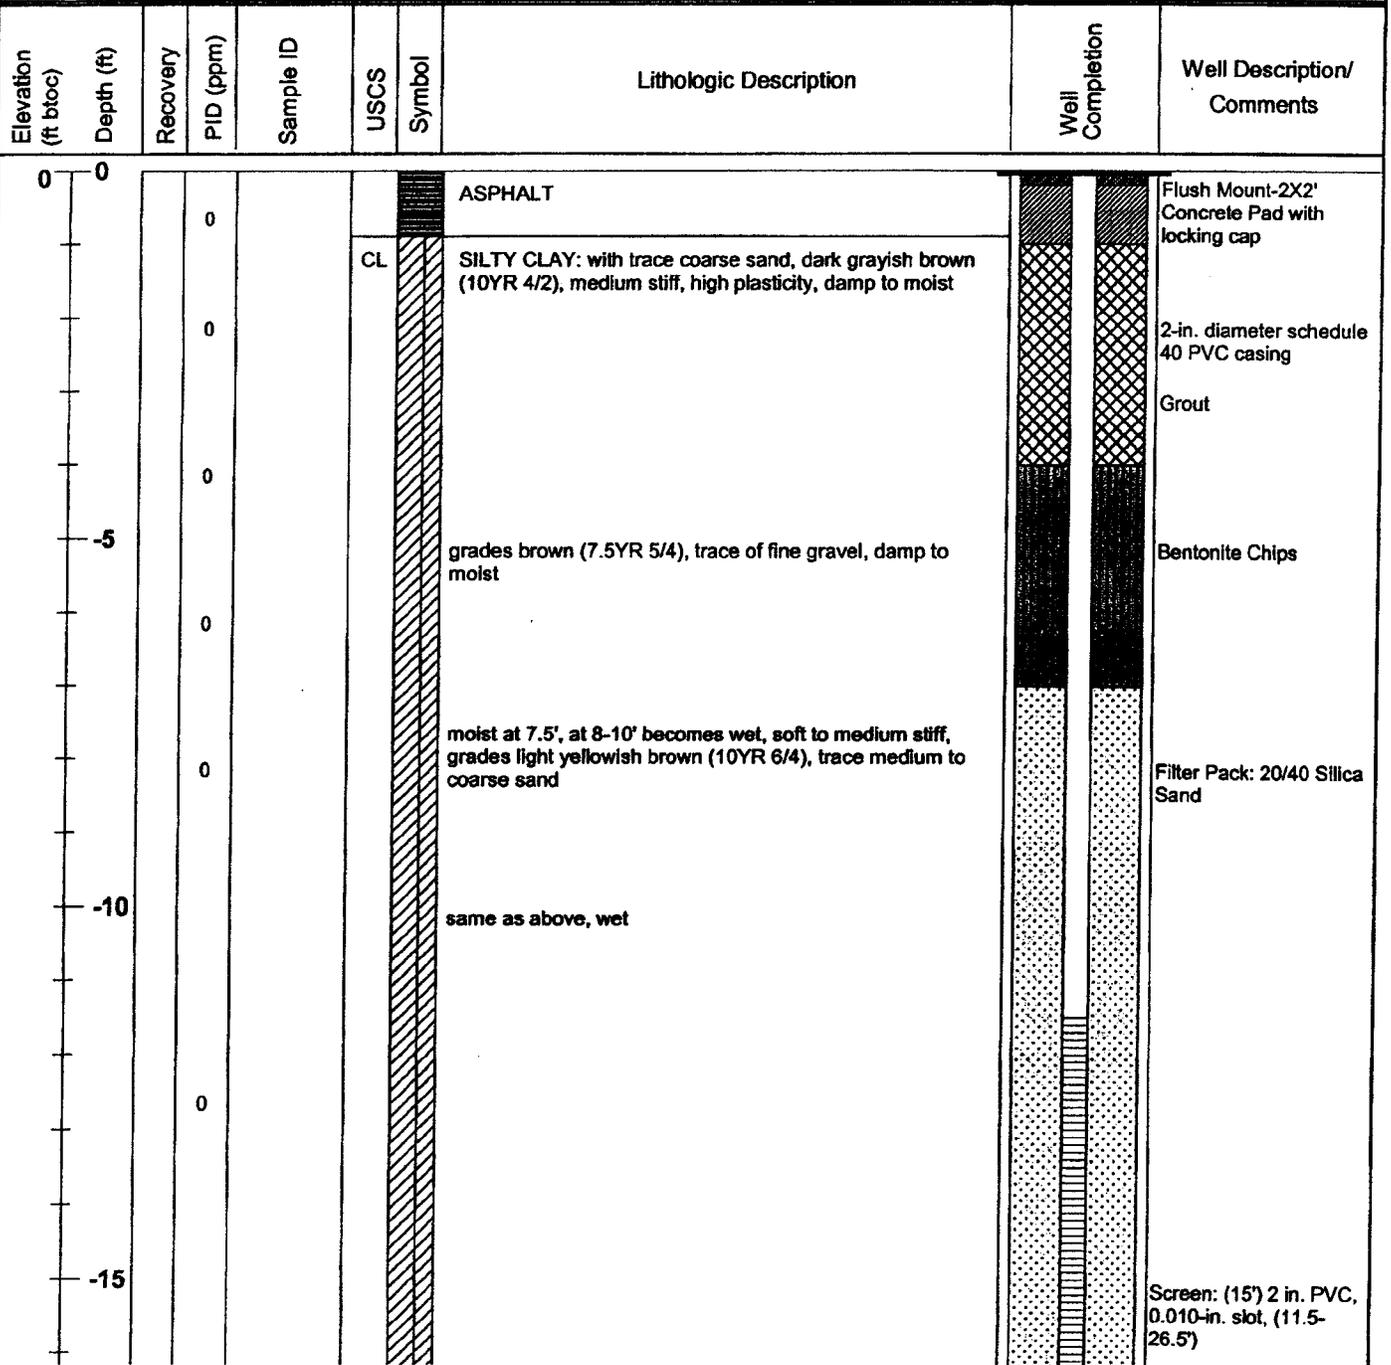
**INSTRUCTIONS:** Use typewriter or ball point pen. PLEASE PRESS FIRMLY and PRINT clearly. Please fill in blanks, underline or circle the correct answers. Send top three copies to Kansas Department of Health and Environment, Bureau of Water, Geology Section, 1000 SW Jackson St., Suite 420, Topeka, Kansas 66612-1367. Telephone 785-296-5522. Send one to WATER WELL OWNER and retain one for your records. Fee of \$5.00 for each constructed well. Visit us at <http://www.kdheks.gov/waterwell/index.html>.

## SOIL BORING AND WELL LOG

Boring/Well ID: MW-24

Total Depth: 27 ft bgs

| PROJECT INFORMATION                   |  | DRILLING INFORMATION                |   |
|---------------------------------------|--|-------------------------------------|---|
| Project: Unocal/Wichita               |  | Drilling Company: PSA               |   |
| Site Location: Wichita, KS            |  | Driller: Aaron Sense                |   |
| Site Name: Coleman                    |  | Equipment: Geoprobe 6620 DT         |   |
| Geologist: Kim Nguyen                 |  | Drilling Method: Hollow Stem Augers |   |
| Project Manager: Derek Peacock        |  | Sampling Method: Auger Cuttings     |   |
| Ground Water Depth (ft bgs): 8 ft bgs |  | Dates Drilled: 6/19/08              |   |
| Top of Casing Elevation (ft msl):     |  | Screened Interval: 11.5-26.5 ft bgs |   |
| Ground Surface Elevation (ft msl):    |  | Coordinates: N                      | E |
| PG Signature:                         |  |                                     |   |





# SOIL BORING/ WELL LOG Boring/Well ID: MW-24

| Elevation (ft btoc) | Depth (ft) | Recovery | PID (ppm) | Sample ID | USCS | Symbol | Lithologic Description   | Well Completion | Well Description/ Comments |
|---------------------|------------|----------|-----------|-----------|------|--------|--|-----------------|----------------------------|
| -20                 | 0          |          |           |           |      |        | wet to saturated, increasing sand, at 19.5 grades gray (5Y 5/1), very soft   |                 |                            |
| -25                 | 1.8        |          |           |           | ML   |        | SILT: dark gray (2.5Y 4/1) and pink (7.5YR 7/3), soft, high plasticity, saturated, hydrocarbon odor, grades to greenish gray (5GY 7/1) from 24-27' |                 |                            |
|                     | 0.5        |          |           |           |      |        |  |                 |                            |