Cancel

WATER WELL PLUGGING RECORD Form WWC-5P KSA 82a-1212 ID No. MW-7

1 LOCATION OF WATER WELL:	Fraction	Section Number	Township Number	Range Number
County: Sedgwick	NW ¼ NW ¼ NW ¼	19	26S	01E

Distance and direction from nearest town or city street address of well if located within city?
2435 W. 53rd Street Wichita KS

2 WATER WELL OWNER: James T Ross
RR#, St. Address, Box # 825 E 2nd
City, State, ZIP Code : Wichita KS 67202

Board of Agriculture, Division of Water Resources
Application Number:

3 MARK WELL'S LOCATON WITH AN "X" IN SECTION BOX:

X

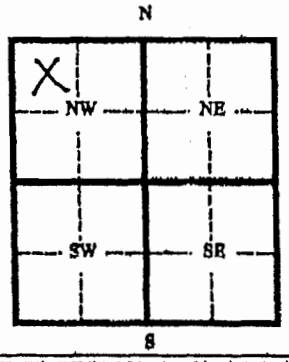

4 DEPTH OF WELL 14.9 ft.

WELL'S STATIC WATER LEVEL 14 ft.

WELL WAS USED AS:

1 Domestic 5 Public Water Supply 9 Dewatering
2 Irrigation 6 Oil Field Water Supply (10) Monitoring Well
3 Feedlot 7 Lawn and Garden (domestic) 11 Injection Well
4 Industrial 8 Air Conditioning 12 Other

Was a chemical/bacteriological sample submitted to Department? Yes ... (No)...
If yes, mo/day/yr sample was submitted
Water Well Disinfected: Yes ..... No .....

5 TYPE OF BLANK CASING USED:

1 Steel 3 RMP (SR) 5 Wrought 7 Fiberglass 9 Other (specify below)
(2 PVC) 4 ABC 6 Asbestos-Cement 8 Concrete Tile

Blank casing diameter 2 in. Was casing pulled? Yes X No ..... If yes, how much Over drilled to 20'

Casing height above or below land surface ..... in.

6 GROUT PLUG MATERIAL: 1 Neat cement 2 Cement grout (3 Bentonite) 4 Other

Grout Plug Intervals From 0 ft. to 20 ft. From ..... ft. to ..... ft. From ..... ft. to ..... ft.

What is the nearest source of possible contamination:

1 Septic tank 6 Seepage pit 11 Fuel storage 16 Other (specify below)
2 Sewer lines 7 Pit privy 12 Fertilizer storage Old Gas Station
3 Watertight sewer lines 8 Sewage lagoon 13 Insecticide storage on site.
4 Lateral lines 9 Feedyard 14 Abandoned water well
5 Cess Pool 10 Livestock pens 15 Oil well/ Gas well

Direction from well? ..... How many feet? .....

FROM	TO	CODE	PLUGGING MATERIALS
0	20		Bentonite.

RECEIVED
JAN 08 2009
BUREAU OF WATER

7 CONTRACTOR'S OR LANDOWNER'S CERTIFICATION: This water well was plugged under my jurisdiction and was completed on (mo/day/yr) 9/5/06 and this record is true to the best of my knowledge and belief. Kansas Water Well Contractor's License No. 554 This Water Well Record was completed on (mo/day/yr) 10/4/06 under the business name of Bluestem Env. Engineering / Woofter by (signature) [signature] Gary L. Woofter

INSTRUCTIONS: Please fill in blanks and circle the correct answers. Send three copies to Kansas Department of Health and Environment, Bureau of Water, 1000 S W Jackson St., Ste. 420, Topeka, Kansas 66620-0001. Telephone: 785-296-5565. Send one to Water Well Owner and retain one for your records.