

WATER WELL PLUGGING RECORD

Form WWC-5P

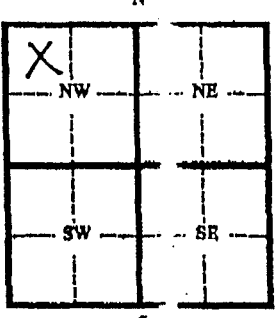
KSA 82a-1212

ID No.

MW-11

1 LOCATION OF WELL:	Fraction	Section Number	Township Number	Range Number
County: <u>Sedgewick</u>	<u>NW 1/4 NW 1/4 NW 1/4</u>	<u>19</u>	<u>26S</u>	<u>01E</u>
Distance and direction from nearest town or city street address of well if located within city? <u>2435 W. 53rd Street</u>				

2 WATER WELL OWNER:	Board of Agriculture, Division of Water Resources
RR#, St. Address, E x #	Application Number:
City, State, ZIP Code	
<u>JAMES T ROSS</u>	
<u>825 E. 2nd</u>	
<u>Wichita KS 67202</u>	

3 MARK WELL'S LOCATION WITH AN "X" IN SECTION BLOCK:	4 DEPTH OF WELL												
	<u>15.4</u> ft.												
	WELL'S STATIC WATER LEVEL <u>~14</u> ft.												
	WELL WAS USED AS:												
	<table border="0"> <tr> <td>1 Domestic</td> <td>5 Public Water Supply</td> <td>9 Dewatering</td> </tr> <tr> <td>2 Irrigation</td> <td>6 Oil Field Water Supply</td> <td><u>10 Monitoring Well</u></td> </tr> <tr> <td>3 Feedlot</td> <td>7 Lawn and Garden (domestic)</td> <td>11 Injection Well</td> </tr> <tr> <td>4 Industrial</td> <td>8 Air Conditioning</td> <td>12 Other</td> </tr>
	Was a chemical/bacteriological sample submitted to Department? Yes <input type="checkbox"/> No <input checked="" type="checkbox"/>												
	If yes, mo/day/yr sample was submitted												
	Water Well Disinfected: Yes <input type="checkbox"/> No <input type="checkbox"/>												

5 TYPE OF BLANK Casing USED:	3 RMP (SR)	5 Wrought	7 Fiberglass	9 Other (specify below)
<u>2 PVC</u>	4 ABC	6 Asbestos-Cement	8 Concrete Tile	
Blank casing diameter: <u>2</u> in.	Was casing pulled? Yes <input checked="" type="checkbox"/> No <input type="checkbox"/>	If yes, how much <u>overdrilled to 20'</u>		
Casing height above or below land surface	in.			

6 GROUT PLUG MATERIAL:	1 Neat cement	2 Cement grout	<u>3 Bentonite</u>	4 Other
Grout Plug Interval	From <u>0</u> ft. to <u>20</u> ft.	From	ft. to	ft. From
What is the nearest source of possible contamination:				
1 Septic tank	6 Seepage pit	11 Fuel storage	16 Other (specify below)	
2 Sewer lines	7 Pit privy	12 Fertilizer storage	<u>Old Gas Station</u>	
3 Watertight sewer lines	8 Sewage lagoon	13 Insecticide storage	<u>on site.</u>	
4 Lateral lines	9 Feedyard	14 Abandoned water well		
5 Cess Pool	10 Livestock pens	15 Oil well/ Gas well		
Direction from well?	How many feet?			

FROM	TO	CODE	PLUGGING MATERIALS
0	20		Bentonite

RECEIVED

JAN 08 2009

BUREAU OF WATER

7 CONTRACTOR OR LANDOWNER'S CERTIFICATION:	This water well was plugged under my jurisdiction and was completed
on (mo/day/yr)	<u>9/5/06</u> and this record is true to the best of my knowledge and belief. Kansas
Water Well Contractor's License No.	<u>554</u> This Water Well Record was completed on (mo/day/yr)
<u>10/4/06</u>	under the business name of <u>Bluestem Env. Engineering / Woofler</u>
by (signature)	<u>N. H. H.</u>

INSTRUCTION: Please fill in blanks and circle the correct answers. Send three copies to Kansas Department of Health and Environment, Bureau of Water, 1000 S W Jackson St., Ste. 420, Topeka, Kansas 66620-0001. Telephone: 785-296-3565. Send one to Water Well Owner and retain one for your records.