

Cancelled

WATER WELL PLUGGING RECORD

Form WWC-5P

KSA 82a-1212


ID No.

SU-3

1 LOCATION OF WATER WELL: Fraction	Section Number	Township Number	Range Number
County: <i>Sedgwick</i> <i>NW 1/4 NW 1/4 NW 1/4</i>	<i>19</i>	<i>26S</i>	<i>01E</i>

Distance and direction from nearest town or city street address of well if located within city?
2435 W. 53rd Street

2 WATER WELL OWNER: RR#, St. Address, Box #	Board of Agriculture, Division of Water Resources
City, State, ZIP Code	Application Number:
<i>JAMES T ROSS</i> <i>825 E 2nd</i> <i>Wichita KS 67202</i>	

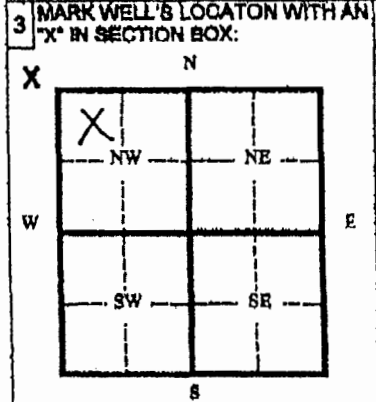

4 DEPTH OF WELL *12* ft.

WELL'S STATIC WATER LEVEL _____ ft.

WELL WAS USED AS:

1 Domestic	5 Public Water Supply	9 Dewatering
2 Irrigation	6 Oil Field Water Supply	<input checked="" type="radio"/> 10 Monitoring Well
3 Feedlot	7 Lawn and Garden (domestic)	11 Injection Well
4 Industrial	8 Air Conditioning	12 Other

Was a chemical/bacteriological sample submitted to Department? Yes No

If yes, mo/day/yr sample was submitted _____

Water Well Disinfected: Yes No

5 TYPE OF BLANK CASING USED:

1 Steel	3 RMP (SR)	5 Wrought	7 Fiberglass	8 Other (specify below)
<input checked="" type="radio"/> 2 PVC	4 ABC	6 Asbestos-Cement	8 Concrete Tile	

Blank casing diameter *4* in. Was casing pulled? Yes No If yes, how much *Cancelled to 12'*

Casing height above or below land surface _____ in.

6 GROUT PLUG MATERIAL: 1 Neat cement 2 Cement grout 3 Bentonite 4 Other _____

Grout Plug Intervals From *0* ft. to *12* ft. From _____ ft. to _____ ft. From _____ ft. to _____ ft.

What is the nearest source of possible contamination:

1 Septic tank	6 Seepage pit	11 Fuel storage	16 Other (specify below)
2 Sewer lines	7 Pit privy	12 Fertilizer storage	<i>Old Gas Station</i>
3 Watertight sewer lines	8 Sewage lagoon	13 Insecticide storage	<i>on site.</i>
4 Lateral lines	9 Feedyard	14 Abandoned water well	
5 Cess Pool	10 Livestock pens	15 Oil well Gas well	

Direction from well? _____ How many feet? _____

FROM	TO	CODE	PLUGGING MATERIALS
<i>0</i>	<i>12</i>		<i>Bentonite</i>

RECEIVED
JAN 08 2009
BUREAU OF WATER

7 CONTRACTOR'S OR LANDOWNER'S CERTIFICATION: This water well was plugged under my jurisdiction and was completed on (mo/day/yr) *9/6/06* and this record is true to the best of my knowledge and belief. Kansas Water Well Contractor's License No. *554* This Water Well Record was completed on (mo/day/yr) *10/4/06* under the business name of *Bluestem Env. Engineering/Water* by (signature) *Paul Woofter*

INSTRUCTIONS: Please fill in blanks and circle the correct answers. Send three copies to Kansas Department of Health and Environment, Bureau of Water, 1000 S W Jackson St., Ste. 420, Topeka, Kansas 66620-0001. Telephone: 785-298-3585. Send one to Water Well Owner and retain one for your records.