

*Carroll*

WATER WELL PLUGGING RECORD

Form WWC-5P

KSA 82a-1212

ID No.


SU 2-1

1 LOCATION OF WATER WELL: Fraction NW 1/4 NW 1/4 NW 1/4 Section Number 19 Township Number 26S Range Number 01E  
 County: Sedgwick

Distance and direction from nearest town or city street address of well if located within city?  
2435 W. 53rd Street

2 WATER WELL OWNER: JAMES T ROSS Board of Agriculture, Division of Water Resources  
 RR#, St. Address, Box # 825 E. 2nd Application Number:  
 City, State, ZIP Code: Wichita KS 67202

3 MARK WELL'S LOCATION WITH AN "X" IN SECTION BOX:

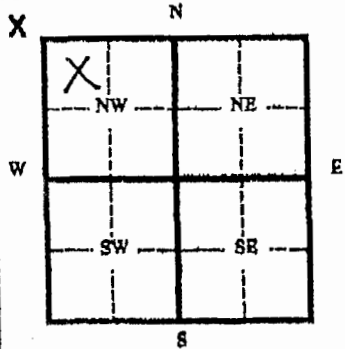

4 DEPTH OF WELL 12 ft.

WELL'S STATIC WATER LEVEL \_\_\_\_\_ ft.

- WELL WAS USED AS:
- 1 Domestic
  - 2 Irrigation
  - 3 Feedlot
  - 4 Industrial
  - 5 Public Water Supply
  - 6 Oil Field Water Supply
  - 7 Lawn and Garden (domestic)
  - 8 Air Conditioning
  - 9 Dewatering
  - 10 Monitoring Well
  - 11 Injection Well
  - 12 Other

Was a chemical/bacteriological sample submitted to Department? Yes No  
 If yes, mo/day/yr sample was submitted \_\_\_\_\_  
 Water Well Disinfected: Yes \_\_\_\_\_ No \_\_\_\_\_

5 TYPE OF BLANK CASING USED:  
 1 Steel 2 PVC 3 RMP (SR) 4 ABC 5 Wrought 6 Asbestos-Cement 7 Fiberglass 8 Concrete Tile 9 Other (specify below)  
 Blank casing diameter 4 in. Was casing pulled? Yes X No \_\_\_\_\_ If yes, how much Overdrilled to 12'  
 Casing height above or below land surface \_\_\_\_\_ in.

6 GROUT PLUG MATERIAL: 1 Neat cement 2 Cement grout 3 Bentonite 4 Other \_\_\_\_\_  
 Grout Plug Intervals From 0 ft. to 12 ft. From \_\_\_\_\_ ft. to \_\_\_\_\_ ft. From \_\_\_\_\_ ft. to \_\_\_\_\_ ft.

- What is the nearest source of possible contamination:
- 1 Septic tank
  - 2 Sewer lines
  - 3 Watertight sewer lines
  - 4 Lateral lines
  - 5 Cess Pool
  - 6 Seepage pit
  - 7 Pitt privy
  - 8 Sewage lagoon
  - 9 Feedyard
  - 10 Livestock pens
  - 11 Fuel storage
  - 12 Fertilizer storage
  - 13 Insecticide storage
  - 14 Abandoned water well
  - 15 Oil well/ Gas well
  - 16 Other (specify below) Old Gas Station on site

Direction from well? \_\_\_\_\_ How many feet? \_\_\_\_\_

FROM	TO	CODE	PLUGGING MATERIALS
0	12		Bentonite

RECEIVED  
 JAN 08 2009  
 BUREAU OF WATER

7 CONTRACTOR'S OR LANDOWNER'S CERTIFICATION: This water well was plugged under my jurisdiction and was completed on (mo/day/yr) 9/7/06 and this record is true to the best of my knowledge and belief. Kansas Water Well Contractor's License No. 554 This Water Well Record was completed on (mo/day/yr) 10/4/06 under the business name of Blostein Env. Engineering / Webster by (signature) Neil H. H.

INSTRUCTIONS: Please fill in blanks and circle the correct answers. Send three copies to Kansas Department of Health and Environment, Bureau of Water, 1000 S W Jackson St., Ste. 420, Topeka, Kansas 66620-0001. Telephone: 785-298-3585. Send one to Water Well Owner and retain one for your records.