

WATER WELL PLUGGING RECORD

Form WWC-5P

KSA B2a-1212


ID No.

*Corrected*  
SUZ-2

1 LOCATION OF WATER WELL:	Fraction	Section Number	Township Number	Range Number
County: <i>Sedgwick</i>	<i>NW 1/4 NW 1/4 NW 1/4</i>	<i>19</i>	<i>26S</i>	<i>01E</i>

Distance and direction from nearest town or city street address of well if located within city?  
*2435 W. 53rd Street*

2 WATER WELL OWNER:	Board of Agriculture, Division of Water Resources
RR#, St. Address, Box #	Application Number:
<i>JAMES T ROSS</i>	
City, State, ZIP Code	
<i>825 E 2nd</i>	
<i>Wichita KS 67202</i>	

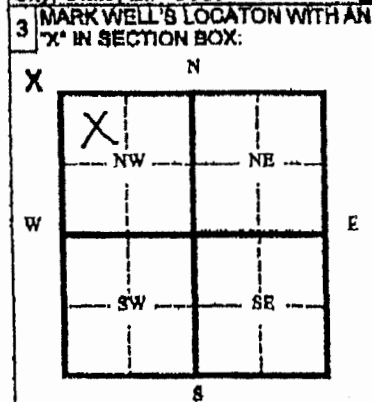

4 DEPTH OF WELL	ft.	
<i>12</i>		
WELL'S STATIC WATER LEVEL	ft.	
<i>—</i>		
WELL WAS USED AS:		
1 Domestic	5 Public Water Supply	9 Dewatering
2 Irrigation	6 Oil Field Water Supply	10 Monitoring Well
3 Feedlot	7 Lawn and Garden (domestic)	11 Injection Well
4 Industrial	8 Air Conditioning	12 Other
Was a chemical/bacteriological sample submitted to Department? Yes <input type="checkbox"/> No <input checked="" type="checkbox"/>		
If yes, mo/day/yr sample was submitted _____		
Water Well Disinfected: Yes <input type="checkbox"/> No <input type="checkbox"/>		

5 TYPE OF BLANK CASING USED:

1 Steel	3 RMP (SR)	5 Wrought	7 Fiberglass	9 Other (specify below)
2 PVC	4 ABC	6 Asbestos-Cement	8 Concrete Tile	

Blank casing diameter *4* in. Was casing pulled? Yes  No  If yes, how much *Overdrilled to 12'*

Casing height above or below land surface \_\_\_\_\_ in.

6 GROUT PLUG MATERIAL: 1 Neat cement 2 Cement grout 3 Bentonite 4 Other

Grout Plug Intervals From *0* ft. to *12* ft. From \_\_\_\_\_ ft. to \_\_\_\_\_ ft. From \_\_\_\_\_ ft. to \_\_\_\_\_ ft.

What is the nearest source of possible contamination:

1 Septic tank	6 Seepage pit	11 Fuel storage	18 Other (specify below)
2 Sewer lines	7 Pit privy	12 Fertilizer storage	<i>Old Gas Station</i>
3 Watertight sewer lines	8 Sewage lagoon	13 Insecticide storage	<i>on site.</i>
4 Lateral lines	9 Feedyard	14 Abandoned water well	
5 Cess Pool	10 Livestock pens	15 Oil well/ Gas well	

Direction from well? \_\_\_\_\_ How many feet? \_\_\_\_\_

FROM	TO	CODE	PLUGGING MATERIALS
<i>0</i>	<i>12</i>		<i>Bentonite</i>

RECEIVED  
JAN 08 2009  
BUREAU OF WATER

7 CONTRACTOR'S OR LANDOWNER'S CERTIFICATION: This water well was plugged under my jurisdiction and was completed on (mo/day/yr) *7/9/06* and this record is true to the best of my knowledge and belief. Kansas Water Well Contractor's License No. *554* This Water Well Record was completed on (mo/day/yr) *10/4/06* under the business name of *Bluestem Env. Engineering/Woofers* by (signature) *[Signature]*

INSTRUCTIONS: Please fill in blanks and circle the correct answers. Send three copies to Kansas Department of Health and Environment, Bureau of Water, 1000 S W Jackson St., Ste. 420, Topeka, Kansas 66620-0001. Telephone: 785-296-3565. Send one to Water Well Owner and retain one for your records.