

Corrected
513-3

WATER WELL PLUGGING RECORD

Form WWC-5P


KSA 82a-1212

ID No.

1 LOCATION OF WATER WELL: Fraction	Section Number	Township Number	Range Number
County: <u>Sedgwick</u> <u>NW 1/4 NW 1/4 NW 1/4</u>	<u>19</u>	<u>26S</u>	<u>01E</u>

Distance and direction from nearest town or city street address of well if located within city?
2435 W. 53rd Street

2 WATER WELL OWNER: RR#, St. Address, Box #	Board of Agriculture, Division of Water Resources
City, State, ZIP Code	Application Number:
<u>JAMES T ROSS</u> <u>825 E. 2nd</u> <u>Wichita KS 67202</u>	

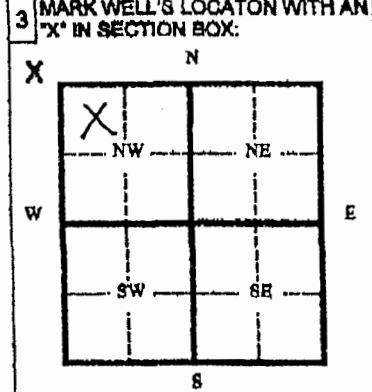

4 DEPTH OF WELL 12 ft.

WELL'S STATIC WATER LEVEL — ft.

WELL WAS USED AS:

1 Domestic	5 Public Water Supply	9 Dewatering
2 Irrigation	6 Oil Field Water Supply	10 Monitoring Well
3 Feedlot	7 Lawn and Garden (domestic)	11 Injection Well
4 Industrial	8 Air Conditioning	12 Other

Was a chemical/bacteriological sample submitted to Department? Yes No

If yes, mo/day/yr sample was submitted _____

Water Well Disinfected: Yes No

5 TYPE OF BLANK CASING USED:

1 Steel	3 RMP (SR)	5 Wrought	7 Fiberglass	9 Other (specify below)
2 PVC	4 ABC	6 Asbestos-Cement	8 Concrete Tile	

Blank casing diameter 4 in. Was casing pulled? Yes No If yes, how much Overdrilled to 12'

Casing height above or below land surface _____ in.

6 GROUT PLUG MATERIAL: 1 Neat cement 2 Cement grout 3 Bentonite 4 Other

Grout Plug Intervals From 0 ft. to 12 ft. From _____ ft. to _____ ft. From _____ ft. to _____ ft.

What is the nearest source of possible contamination:

1 Septic tank	6 Seepage pit	11 Fuel storage	16 Other (specify below)
2 Sewer lines	7 Pit privy	12 Fertilizer storage	<u>Old Gas Station</u>
3 Watertight sewer lines	8 Sewage lagoon	13 Insecticide storage	<u>on site.</u>
4 Lateral lines	9 Feedyard	14 Abandoned water well	
5 Cess Pool	10 Livestock pens	15 Oil well/ Gas well	

Direction from well? _____ How many feet? _____

FROM	TO	CODE	PLUGGING MATERIALS
<u>0</u>	<u>12</u>		<u>Bentonite.</u>

RECEIVED
JAN 08 2009
BUREAU OF WATER

7 CONTRACTOR'S OR LANDOWNER'S CERTIFICATION: This water well was plugged under my jurisdiction and was completed on (mo/day/yr) 9/6/06 and this record is true to the best of my knowledge and belief. Kansas Water Well Contractor's License No. 554 This Water Well Record was completed on (mo/day/yr) 10/4/06 under the business name of Bluebonn Eny. Engrng/Well Driller by (signature) [Signature]

INSTRUCTIONS: Please fill in blanks and circle the correct answers. Send three copies to Kansas Department of Health and Environment, Bureau of Water, 1000 S W Jackson St., Ste. 420, Topeka, Kansas 66620-0001. Telephone: 785-296-3566. Send one to Water Well Owner and retain one for your records.