


1	LOCATION OF WATER WELL:	Fraction	Section Number	Township Number	Range Number
County: Sedgwick	1/4 SE 1/4 SW 1/4 SW	34	26	1	E/W

Distance and direction from nearest town or city street address of well if located within city?
In Wichita - 1/4 mile East of I135 & New York St.

2 WATER WELL OWNER: **Kansas Army National Guard**
c/o Latimer Sommers & Assoc.
 RR #, St. Address, Box #: **3639 SW Summerfield Dr.** Board of Agriculture, Division of Water Resources
 City, State, ZIP Code: **Suite A, Topeka, KS 66614-3972** Application Number: _____

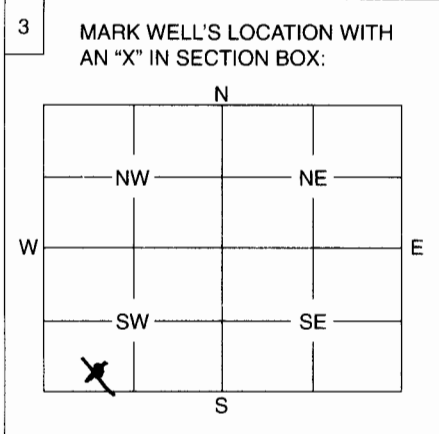

4 DEPTH OF WELL **300** ft.
 WELL'S STATIC WATER LEVEL **15** ft.
 WELL WAS USED AS:

1 Domestic	5 Public Water Supply	9 Dewatering
2 Irrigation	6 Oil Field Water Supply	10 Monitoring Well
3 Feedlot	7 Domestic (Lawn & Garden)	11 Injection Well
4 Industrial	8 Air Conditioning	12 <input checked="" type="checkbox"/> Other Geo-Thermal Heat Pump

Was a chemical / bacteriological sample submitted to Department? Yes No
 If yes, mo/day/yr sample was submitted

Water Well Disinfected: Yes No

5 TYPE OF BLANK CASING USED:

1 Steel	3 RMP (SR)	5 Wrought	7 Fiberglass	<input checked="" type="checkbox"/> Other (Specify below)
2 PVC	4 ABS	6 Asbestos-Cement	8 Concrete Tile	Polyethylene

Blank casing diameter **1** in. Was casing pulled? Yes No If yes, how much

Casing height above or below land surface in.

6 GROUT PLUG MATERIAL: 1 Neat cement 2 Cement grout Bentonite 4 Other

Grout Plug Intervals: From **3** ft. to **300** ft., From ft. to ft., From to ft.

What is the nearest source of possible contamination:

1 Septic tank	6 Seepage pit	11 Fuel storage	<input checked="" type="checkbox"/> Other (specify below)
2 Sewer lines	7 Pit privy	12 Fertilizer storage	None within 1/4 mile
3 Watertight sewer lines	8 Sewage lagoon	13 Insecticide storage	
4 Lateral lines	9 Feedyard	14 Abandoned water well	
5 Cess pool	10 Livestock pens	15 Oil well/Gas well	

Direction from well? How many feet?

FROM	TO	Log	PLUGGING MATERIALS
0	5	Topsoil	
5	9	Clay, black	170 245
9	18	Clay, dark brown	
18	30	Sand, fine to coarse	
30	53	Sand, Medium to coarse with gravel	245 300
53	75	Shale, gray with limestone	
75	96	Shale, gray	
96	145	Limestone, hard	
145	170	Shale, gray, hard	

7 CONTRACTOR'S OF LANDOWNER'S CERTIFICATION: This water well was plugged under my jurisdiction and was completed on (mo/day/year) **4/16/09** and this record is true to the best of my knowledge and belief. Kansas Water Well Contractor's License No. **138** This Water Well Record was completed on (mo/day/year) **4/20/09** under the business name of **Peterson Irrigation, Inc.**
 by (signature) *Mike Peterson*

INSTRUCTIONS: Use typewriter or ball point pen. Please press firmly and print clearly. Please fill in blanks, underline or circle the correct answers. Send top three copies to Kansas Department of Health and Environment, Bureau of Water, Geology Section, 1000 SW Jackson St., Ste. 420, Topeka, Kansas 66612-1367. Telephone: 785/296-5522. Send one to Water Well Owner and retain one for your records.