

# WATER WELL PLUGGING RECORD Form WWC-5P

KSA 82a-1212

ID NO.

1 LOCATION OF WATER WELL: Fraction NW 1/4 SW 1/4 NE 1/4 Section Number 31 Township Number 7265 Range Number R1E E/W


Distance and direction from nearest town or city street address of well if located within city?

Northwest corner of Garage - 1710 W 34th St. N Wichita KS

2 WATER WELL OWNER: Georgia Englebert  
RR#, St. Address, Box #: 1710 W 34th St. N  
City, State ZIP Code: Wichita KS 67204

Global Positioning Systems (decimal degrees, min. of 4 digits)  
Latitude: \_\_\_\_\_  
Longitude: \_\_\_\_\_  
Elevation: \_\_\_\_\_  
Datum: \_\_\_\_\_  
Data Collection Method: \_\_\_\_\_

3 MARK WELL'S LOCATION WITH AN "X" IN SECTION BOX:

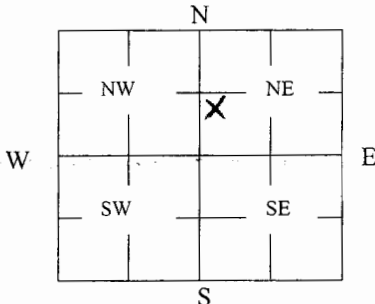

4 DEPTH OF WELL 24 ft.

WELL'S STATIC WATER LEVEL 13 ft

WELL WAS USED AS:

- |              |   |                   |
|--------------|---|-------------------|
| 1 Domestic   | 5 Public Water Supply                     | 9 Dewatering      |
| 2 Irrigation | 6 Oil Field Water Supply                  | 10 Monitoring     |
| 3 Feedlot    | <del>7 Domestic (Lawn &amp; Garden)</del> | 11 Injection Well |
| 4 Industrial | 8 Air Conditioning                        | 12 Other _____    |

Was a chemical/bacteriological sample submitted to Department? Yes \_\_\_\_\_ No ☒

5 TYPE OF BLANK CASING USED:

- |         |            |                   |                 |                         |
|---------|------------|-------------------|-----------------|-------------------------|
| 1 Steel | 3 RMP (SR) | 5 Wrought         | 7 Fiberglass    | 9 Other (Specify below) |
| 2 PVC   | 4 ABS      | 6 Asbestos-Cement | 8 Concrete Tile |                         |

Blank casing diameter 1 1/4 in. Was casing pulled? Yes \_\_\_\_\_ No ☒ If yes, how much \_\_\_\_\_  
Casing height above or below land surface - 0 - in.

6 GROUT PLUG MATERIAL: 1 Neat cement 2 Cement grout 3 Bentonite 4 Other \_\_\_\_\_

Grout Plug Intervals: From \_\_\_\_\_ ft. to \_\_\_\_\_ ft., From \_\_\_\_\_ ft. to \_\_\_\_\_ ft., From \_\_\_\_\_ to \_\_\_\_\_ ft.

What is the nearest source of possible contamination:

- |                          |                   |                         |                            |
|--------------------------|-------------------|-------------------------|----------------------------|
| 1 Septic tank            | 6 Seepage pit     | 11 Fuel Storage         | 16 Other (specify below)   |
| 2 Sewer lines            | 7 Pit privy       | 12 Fertilizer storage   | Well was abandoned         |
| 3 Watertight sewer lines | 8 Sewage lagoon   | 13 Insecticide storage  |                            |
| 4 Lateral lines          | 9 Feedyard        | 14 Abandoned water well | Direction from well? _____ |
| 5 Cess pool              | 10 Livestock pens | 15 Oil well/Gas well    | How many feet? _____       |

FROM	TO	PLUGGING MATERIALS	FROM	TO	PLUGGING MATERIALS
1	0	Cement			
24	1	Bentonite / bleach			
					RECEIVED
					DEC 18 2009
					BUREAU OF WATER

7 CONTRACTOR'S OR LANDOWNER'S CERTIFICATION: This water well was plugged under my jurisdiction and was completed on (mo/day/year) 12/16/09 and this record is true to the best of my knowledge and belief. Kansas Water Well Contractor's License No. 629. This Water Well Record was completed on (mo/day/year) 12/16/09 under the business name of JME Enterprises by (signature) James M. Englebert

INSTRUCTIONS: Use typewriter or ballpoint pen. Please press firmly and print clearly. Please fill in blanks, underline or circle the correct answers. Send top three copies to Kansas Department of Health and Environment, Bureau of Water, Geology Section, 1000 SW Jackson St., Ste. 420, Topeka, Kansas 66612-1367. Telephone: 785/296-5522. Send one to Water Well Owner and retain one for your records. Visit us at <http://www.kdheks.gov/geo/waterwells>.