GSI Job No. 097271 **WB-1**

WATER WELL PLUGGING RECORD **Form WWC-5P** **KSA 82a-1212** **ID NO.**

1 **LOCATION OF WATER WELL:** County: **Sedgwick**	Fraction **NE** ¼ **NE** ¼ **NW** ¼	Section Number **35**	Township Number **26S**	Range Number **1** E

Distance and direction from nearest town or city street address of well if located within city?
4111 E. 37th St., Wichita

2 WATER WELL OWNER: Koch Industries, Inc.

RR#, St. Address, Box #: **4111 E. 37th St.**

City, State, ZIP Code: **Wichita, Kansas**

Global Positioning System (decimal degrees, min. of 4 digits)
Latitude: _____
Longitude: _____
Elevation: _____
Datum: _____
Data Collection Method:

3 MARK WELL'S LOCATION WITH AN "X" IN SECTION BOX:

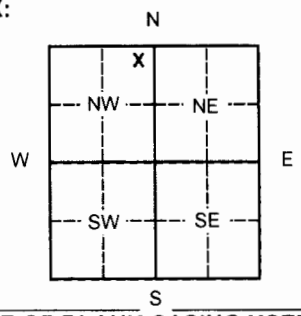

4 DEPTH OF WELL **5.0** **ft.**

WELL'S STATIC WATER LEVEL **4.70** ft

WELL WAS USED AS:

1 Domestic
2 Irrigation
3 Feedlot
4 Industrial
5 Public Water Supply
6 Oil Field Water Supply
7 Domestic (Lawn & Garden)
8 Air Conditioning
9 Dewatering
10 Monitoring
11 Injection Well
12 Other _____

Was a chemical/bacteriological sample submitted to Department? Yes ___ No **X**

5 TYPE OF BLANK CASING USED:
1 Steel 3 RMP (SR) 5 Wrought 7 Fiberglass 9 Other (Specify below)
2 PVC 4 ABS 6 Asbestos-Cement 8 Concrete Tile _____

Blank casing diameter **1** in. Was casing pulled? Yes ___ No **X** If yes, how much _____
Casing height above or below land surface **NA*** ft.

6 GROUT PLUG MATERIAL: 1 Neat cement 2 Cement grout 3 Bentonite 4 Other _____

Grout Plug Intervals: From **0.5** ft. to **5** ft., From ft. to ft., From to ft.

What is the nearest source of possible contamination:
1 Septic tank
2 Sewer lines
3 Watertight sewer lines
4 Lateral lines
5 Cess pool
6 Seepage pit
7 Pit privy
8 Sewage lagoon
9 Feedyard
10 Livestock pens
11 Fuel Storage
12 Fertilizer storage
13 Insecticide storage
14 Abandoned water well
15 Oil well/Gas well
16 Other (specify below) _____

Direction from well?
How many feet?

FROM	TO	PLUGGING MATERIALS	FROM	TO	PLUGGING MATERIALS
0.0	**0.5**	**Concrete**			
0.5	**5.0**	**Bentonite Chips**			
		*** Overdrilled to 5.0' below surface**			

7 CONTRACTOR'S OR LANDOWNER'S CERTIFICATION: This water well was plugged under my jurisdiction and was completed on (mo/day/year) **05/17/10** and this record is true to the best of my knowledge and belief. Kansas Water Well Contractor's License No. **531**. This Water Well Record was completed on (mo/day/year) **06/01/10** under the business name of **Geotechnical Services, Inc.** by (signature) David Edwards.

INSTRUCTIONS: Please fill in blanks or circle the correct answers. Send top three copies to Kansas Department of Health and Environment, Bureau of Water, Geology Section, 1000 SW Jackson St., Ste. 420, Topeka, Kansas 66612-1367. Telephone: 785/296-5522. Send one to Water Well Owner and retain one for your records. Visit us at http://www.kdheks.gov/waterwell.

White Copy

KSA 82a-1212

Form provided by Forms-On-A-Disk, Inc. · Dallas, Texas · (214) 340-9429