


5725 N. Broadway – Wichita

Board of Agriculture, Division of Water Resources

Application Number:

25 ft. ELEVATION: 1333.53 (TOC)

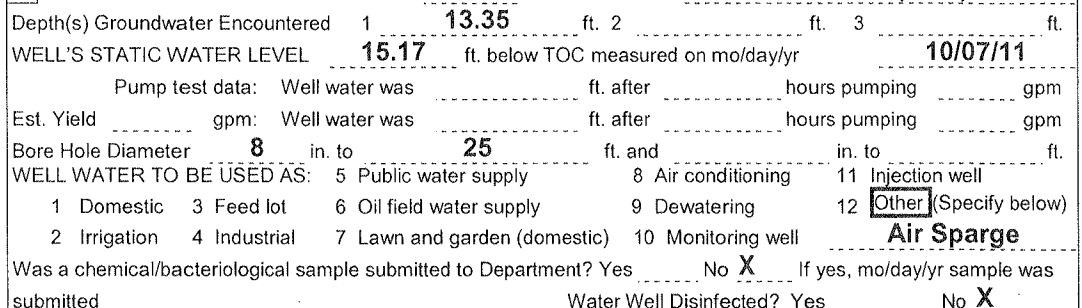

CASING JOINTS: Glued                      Clamped

Welded

Threaded      Flush

Casing height above land surface	0	in., weight	0.703	lbs./ft. Wall thickness or gauge No.	SCH. 40
----------------------------------	---	-------------	-------	--------------------------------------	---------

7 PVC	10 Asbestos-cement
-------	--------------------

8 RMP (SR)

9 ABS

5 Gauzed wrapped

6 Wire wrapped

4 Key punched

From **23** ft. to **25** ft. From \_\_\_\_\_ ft. to \_\_\_\_\_ ft.

From **7** ft. to **25** ft. From \_\_\_\_\_ ft. to \_\_\_\_\_ ft.

3 Bentonite	4 Other
-------------	---------

Grout Intervals From 1 ft. to 7 ft. From        ft. to        ft. From        ft. to        ft.

What is the nearest source of possible contamination:

1 Septic tank

#### 4 Lateral lines

## 7 Pit privy

10 Livestock pens

14 Abandoned water well

## 2 Sewer lines

5 Cess poo

8 Sewage lagoon

## 11 Fuel storage

15 Oil well/ Gas well

### 3 Watertight sewer lines

6 Seepage pit

9 Feedyard

## 12 Fertilizer storage

16 Other (specify below)

Direction from well?

How many feet?

[illegible]

Water Well Contractor's License No. **531** This Water Well Record was completed on (mo/day/yr) **10/20/11**

**Geotechnical Services Inc.**

is Water Well Record was completed on (mo/day/yr) **10/20/11**

by (signature)

INSTRUCTIONS: Please fill in blanks and circle the correct answers. Send three copies to Kansas Department of Health and Environment, Bureau of Water, 1000 S W Jackson St., Ste. 420, Topeka, Kansas 66612-1367. Telephone: 913-296-5545. Send one to WATER WELL OWNER and retain one for your records.