


5725 N. Broadway – Wichita

Board of Agriculture, Division of Water Resources

Application Number:

4 DEPTH OF COMPLETED WELL

20 ft. ELEVATION: 1333.80 (TOC)

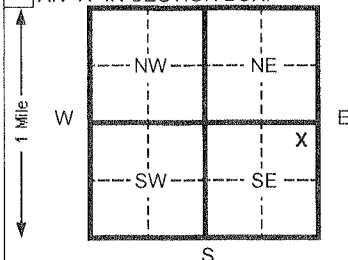

Depth(s) Groundwater Encountered	1	ft.	2	ft.	3	ft.
----------------------------------	---	-----	---	-----	---	-----

Depth(s) Groundwater Encountered 1 \_\_\_\_\_ ft. 2 \_\_\_\_\_ ft. 3 \_\_\_\_\_ ft.  
WELL'S STATIC WATER LEVEL 15.05 ft. below TOC measured on mo/day/yr 10/07/11

	Pump test data:	Well water was	ft. after	hours pumping	gpm
Est. Yield	gpm:	Well water was	ft. after	hours pumping	gpm

Bore Hole Diameter	8	in. to	20	ft. and	in. to	ft.
--------------------	---	--------	----	---------	--------	-----

WELL WATER TO BE USED AS:			5 Public water supply	8 Air conditioning	11 Injection well
1 Domestic	3 Feed lot	6 Oil field water supply	9 Dewatering	12 Other (Specify below)	

2 Irrigation    4 Industrial    7 Lawn and garden (domestic)    10 Monitoring well

Was a chemical/bacteriological sample submitted to Department? Yes \_\_\_\_\_ No **X** If yes, mo/day/yr sample was submitted \_\_\_\_\_

Water Well Disinfected? Yes \_\_\_\_\_ No **X**

5	Wrought iron	8	Concrete tile	CASING JOINTS: Glued	Clamped
---	--------------	---	---------------	----------------------	---------

6 Asbestos-Cement      9 Other (specify below)

7 Fiberglass	Threaded	Flush
--------------	----------	-------

Blank casing diameter **2** in. to **10** ft., Dia in. to ft., Dia in. to ft.

Casing height above land surface	0	in., weight	0.703	lbs./ft. Wall thickness or gauge No.	SCH. 40
----------------------------------	---	-------------	-------	--------------------------------------	---------

TYPE OF SCREEN OR PERFORATION MATERIAL:

1 Steel	3 Stainless steel	5 Fiberglass	8 RMP (SR)	11 Other (specify) _____
2 Brass	4 Galvanized steel	6 Concrete tile	9 ABS	12 None used (open hole)

SCREEN OR PERFORATION OPENINGS ARE:

1 Continuous slot	3 Mill slot	6 Wire wrapped	9 Drilled holes
2 Louvered shutter	4 Key punched	7 Torch cut	10 Other (specify)

SCREEN-PERFORATED INTERVALS: From **10** ft. to **20** ft. From \_\_\_\_\_ ft. to \_\_\_\_\_ ft.

GRAVEL PACK INTERVALS: From 8 ft. to 20 ft. From \_\_\_\_\_ ft. to \_\_\_\_\_ ft.

6	GROUT MATERIAL:	1 Neat cement	2 Cement grout	3 Bentonite	4 Other
---	-----------------	---------------	----------------	-------------	---------

Grout Intervals	From	ft. to	ft.	From	ft. to	ft.	From	ft. to	ft.
		1		8					

What is the nearest source of possible contamination:

1 Septic tank	4 Lateral lines	7 Pit privy	11 Fuel storage	15 Oil well/ Gas well
2 Sewer lines	5 Cess pool	8 Sewage lagoon	12 Fertilizer storage	16 Other (specify below)
3 Watertight sewer lines	6 Seepage pit	9 Feedyard	13 Insecticide storage	

Direction from well?

How many feet?

FROM	TO	CODE	LITHOLOGIC LOG	FROM	TO	PLUGGING INTERVALS
0	9		Clay, black, silty			
9	11		Sand, black, silty to medium sand			
11	15		Clayey Sand, black, very silty, sand content increases with depth			
15	20		Sand, black, fine grained			
						GPS (from SE corner of Section 17): Northing: 2400.38 Easting: 67.90

7 CONTRACTOR'S OR LANDOWNER'S CERTIFICATION: This water well was (1) constructed, (2) reconstructed, or (3) plugged under my jurisdiction and was completed on (mo/day/yr) 10/05/11 and this record is true to the best of my knowledge and belief. Kansas

Water Well Contractor's License No. **531** This Water Well Record was completed on (mo/day/yr) **10/20/11**

under the business name of **Geotechnical Services Inc.**

s Water Well Record was completed on (mo/day/yr) 10/20/11

by (signature) Paul King

INSTRUCTIONS: Please fill in blanks and circle the correct answers. Send three copies to Kansas Department of Health and Environment, Bureau of Water, 1000 S W Jackson St., Ste. 420, Topeka, Kansas 66612-1367. Telephone: 913-296-5545. Send one to WATER WELL OWNER and retain one for your records.