

1 LOCATION OF WATER WELL: Fraction 1/4 SW 1/4 NE 1/4 NW 1/4 Section Number 34 Township Number T 26 S Range Number 1 ☒ E ☐ W  
County: SEDGWICK

Street/Rural Address of Well Location; if unknown, distance & direction from nearest town or intersection: If at owner's address, check here ☐ FORMER UNICOL CHEMICAL DIST. FACILITY

3600 N. HYDRAULIC ST., WICHITA, KS 67219

## Global Positioning Systems (GPS) information:

Latitude: 37.749731 (in decimal degrees)Longitude: -97.311459 (in decimal degrees)

Elevation: \_\_\_\_\_


Datum: ☒ WGS84, ☐ NAD83, ☐ NAD27

Collection Method: \_\_\_\_\_

☐ GPS unit (Make/Model: \_\_\_\_\_)☒ Digital Map/Photo, ☐ Topographic Map, ☐ Land SurveyEst. Accuracy: ☐ < 3 m, ☐ 3-5 m, ☒ 5-15 m, ☐ > 15 m

2 WATER WELL OWNER: CHEVRON ENV. MGT. CO.  
RR#, St. Address, Box #: 6101 BOLLINGER CANYON RD.  
City, State ZIP Code: SAN RAMON, CA 94583

3 MARK WELL'S LOCATION WITH AN "X" IN SECTION BOX:

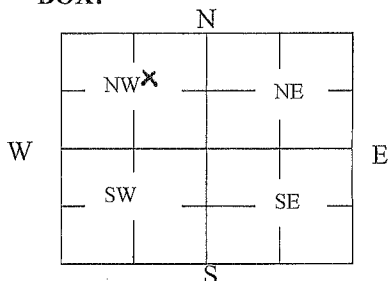

4 DEPTH OF WELL 25 ft.

WELL'S STATIC WATER LEVEL \_\_\_\_\_ ft

WELL WAS USED AS:

☐ Domestic  
☐ Irrigation  
☐ Feedlot  
☐ Industrial☐ Public Water Supply  
☐ Oil Field Water Supply  
☐ Domestic (Lawn & Garden)  
☐ Air Conditioning☐ Dewatering  
☒ Monitoring  
☐ Injection Well  
☐ Other \_\_\_\_\_Was a chemical/bacteriological sample submitted to Department? Yes ☐ No ☐

WELL #:  
PZ-2

5 TYPE OF BLANK CASING USED:

☐ Steel  
☒ PVC☐ RMP (SR)  
☐ ABS☐ Wrought  
☐ Asbestos-Cement☐ Fiberglass  
☐ Concrete Tile☐ Other (Specify below) \_\_\_\_\_

Blank casing diameter 2 in. Was casing pulled? Yes ☒ No ☐ If yes, how much ALL 25'  
Casing height above or below land surface 0 in.

6 GROUT PLUG MATERIAL: ☐ Neat cement ☐ Cement grout ☒ Bentonite ☐ Other \_\_\_\_\_

Grout Plug Intervals: From 3 ft. to 25 ft., From \_\_\_\_\_ ft. to \_\_\_\_\_ ft., From \_\_\_\_\_ to \_\_\_\_\_ ft.

What is the nearest source of possible contamination:

☐ Septic tank  
☐ Sewer lines  
☐ Watertight sewer lines  
☐ Lateral lines  
☐ Cess pool☐ Seepage pit  
☐ Pit privy  
☐ Sewage lagoon  
☐ Feedyard  
☐ Livestock pens☐ Fuel Storage  
☐ Fertilizer storage  
☐ Insecticide storage  
☐ Abandoned water well  
☐ Oil well/Gas well☒ Other (specify below) UPGRADIENT SOURCE PLUMES  
Direction from well? UNKNOWN  
How many feet? UNKNOWN

FROM	TO	PLUGGING MATERIALS	FROM	TO	PLUGGING MATERIALS
<u>0</u>	<u>3'</u>	<u>SALT/FILL</u>			
<u>3'</u>	<u>25'</u>	<u>BENTONITE CHIPS</u>			

7 CONTRACTOR'S OR LANDOWNER'S CERTIFICATION: This water well was plugged under my jurisdiction and was completed on (mo/day/year) 5/23/12 and this record is true to the best of my knowledge and belief. Kansas Water Well Contractor's License No. 788. This Water Well Record was completed on (mo/day/year) 6/25/12 under the business name of ROBERTS ENV. DRILLING, INC. by (signature) [Signature]

INSTRUCTIONS: Use typewriter or ballpoint pen. Please press firmly and print clearly. Please fill in blanks, underline or circle the correct answers. Send top three copies to Kansas Department of Health and Environment, Bureau of Water, Geology Section, 1000 SW Jackson St., Ste. 420, Topeka, Kansas 66612-1367. Telephone: 785/296-5524. Send one to Water Well Owner and retain one for your records. Visit us at <http://www.kdheks.gov/waterwell/index.html>.

REDI JOB #122008

Check one: ☒ White Copy ☐ Blue Copy ☐ Pink Copy