
WATER WELL RECORD Form WWC-5 KSA 82a-1212			
ION OF WATER WELL: FRACTION SECTION NUMBER TOWNSHIP NUMBER	RANGE NUMBER		1BER
gwick SW 1/4 SW 1/4 SE 1/4 22 T 26 S	R	1E	E/W
nd direction from nearest town or city street address of well if located within city?			
N. Marble Falls Wichita, Kansas			
TER WELL OWNER: ROBL CONSTRUCTION			
T. ADDRESS,BOX #: 5842 W. 21st N. Board of Agricu	ulture, Divisio	n of Wat	ter Resou

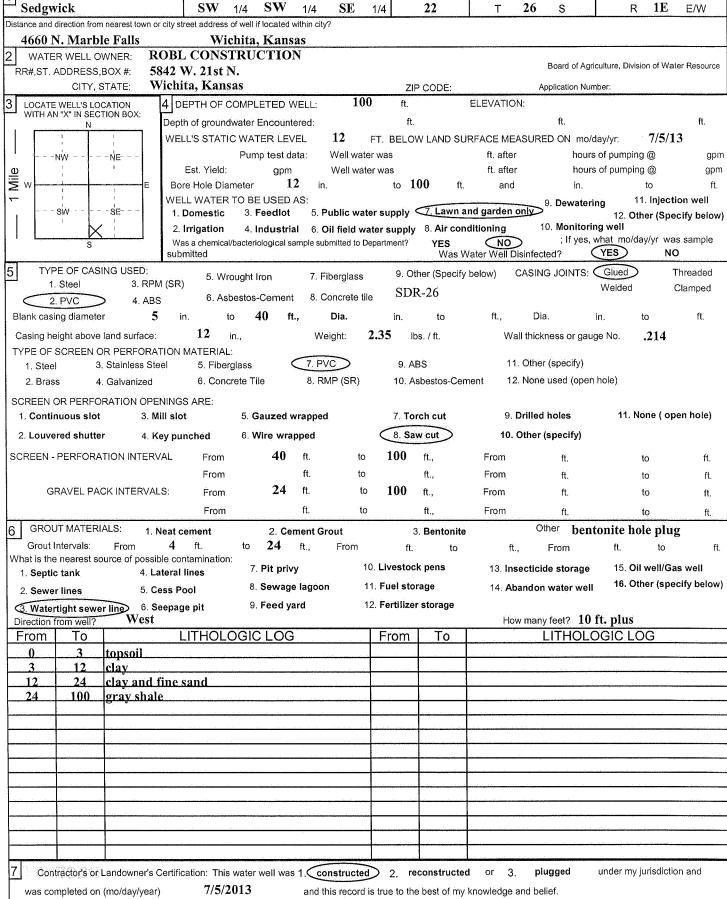

Kansas Water Well Contractor's License No. 236

LOCAT

This water well record was completed on (mo/day/year)

Todd S. Harp