

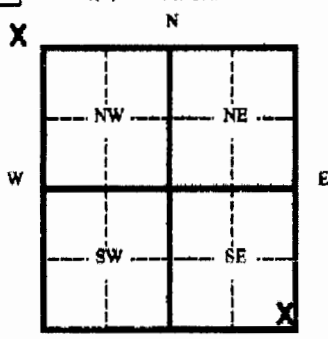
WATER WELL PLUGGING RECORD

Form WWC-5P

KSA 82a-1212

ID No.

AS-5

1 LOCATION OF WATER WELL: County: <u>Sedgwick</u>	Fraction <u>SE 1/4 SE 1/4 SE 1/4</u>	Section Number <u>17</u>	Township Number <u>26S</u>	Range Number <u>1E</u>																																				
Distance and direction from nearest town or city street address of well if located within city? <u>5403 N. Broadway, Wichita, KS</u>	
2 WATER WELL OWNER: <u>Lewis Williams</u> RR#, St. Address, Box # <u>North Highway 56</u> City, State, ZIP Code <u>Moscow, KS</u>	
			Board of Agriculture, Division of Water Resources Application Number:																																					
3 MARK WELL'S LOCATION WITH AN "X" IN SECTION BOX: <div style="text-align: center;">  </div>		4 DEPTH OF WELL <u>30</u> ft. WELL'S STATIC WATER LEVEL <u>14</u> ft. WELL WAS USED AS: <div style="display: flex; justify-content: space-between;"> <div> 1 Domestic 2 Irrigation 3 Feedlot 4 Industrial </div> <div> 5 Public Water Supply 6 Oil Field Water Supply 7 Lawn and Garden (domestic) 8 Air Conditioning </div> <div> 9 Dewatering 10 Monitoring Well 11 Injection Well 12 Other <u>Air Sparge</u> </div> </div> Was a chemical/bacteriological sample submitted to Department? Yes <u> </u> No <u> </u> If yes, mo/day/yr sample was submitted <u> </u> Water Well Disinfected: Yes <u> </u> No <u> </u>																																						
5 TYPE OF BLANK CASING USED: 1 Steel 3 RMP (SR) 5 Wrought 7 Fiberglass 9 Other (specify below) 2 PVC 4 ABC 6 Asbestos-Cement 8 Concrete Tile Blank casing diameter <u>2</u> in. Was casing pulled? Yes <u>x</u> No <u> </u> If yes, how much <u>3</u> feet Casing height above or below land surface <u> </u> in.	
6 GROUT PLUG MATERIAL: 1 Neat cement 2 Cement grout 3 Bentonite 4 Other <u> </u> Grout Plug Intervals From <u> </u> ft. to <u> </u> ft. From <u> </u> ft. to <u> </u> ft. From <u> </u> ft. to <u> </u> ft. What is the nearest source of possible contamination: <div style="display: flex; justify-content: space-between;"> <div> 1 Septic tank 2 Sewer lines 3 Watertight sewer lines 4 Lateral lines 5 Cess Pool </div> <div> 6 Seepage pit 7 Pit privy 8 Sewage lagoon 9 Feedyard 10 Livestock pens </div> <div> 11 Fuel storage 12 Fertilizer storage 13 Insecticide storage 14 Abandoned water well 15 Oil well/ Gas well </div> <div> 16 Other (specify below) <u> </u> </div> </div> Direction from well? <u> </u> How many feet? <u> </u>	
<table border="1" style="width:100%; border-collapse: collapse;"> <thead> <tr> <th style="width:10%;">FROM</th> <th style="width:10%;">TO</th> <th style="width:10%;">CODE</th> <th style="width:70%;">PLUGGING MATERIALS</th> </tr> </thead> <tbody> <tr> <td>0</td> <td>3</td> <td></td> <td>Native materials</td> </tr> <tr> <td>3</td> <td>30</td> <td></td> <td>Bentonite grout</td> </tr> <tr><td> </td><td> </td><td> </td><td> </td></tr> <tr><td> </td><td> </td><td> </td><td> </td></tr> <tr><td> </td><td> </td><td> </td><td> </td></tr> <tr><td> </td><td> </td><td> </td><td> </td></tr> <tr><td> </td><td> </td><td> </td><td> </td></tr> <tr><td> </td><td> </td><td> </td><td> </td></tr> </tbody> </table>					FROM	TO	CODE	PLUGGING MATERIALS	0	3		Native materials	3	30		Bentonite grout																								
FROM	TO	CODE	PLUGGING MATERIALS																																					
0	3		Native materials																																					
3	30		Bentonite grout																																					
7 CONTRACTOR'S OR LANDOWNER'S CERTIFICATION: This water well was plugged under my jurisdiction and was completed on (mo/day/yr) <u>6/17/14</u> and this record is true to the best of my knowledge and belief. Kansas Water Well Contractor's License No. <u>6/23/14</u> This Water Well Record was completed on (mo/day/yr) <u> </u> under the business name of <u>Bluestem Environmental Engineering, Inc.</u> by (signature) <u>Nick Hitt</u>	
INSTRUCTIONS: Please fill in blanks and circle the correct answers. Send three copies to Kansas Department of Health and Environment, Bureau of Water, 1000 S W Jackson St., Ste. 420, Topeka, Kansas 66620-0001. Telephone: 785-298-3585. Send one to Water Well Owner and retain one for your records.	