

WATER WELL PLUGGING RECORD

Form WWC-5P

KSA 82a-1212

ID No.

AS-6

1 LOCATION OF WATER WELL:	Fraction	Section Number	Township Number	Range Number
County: Sedgwick	SE ¼ SE ¼ SE ¼	17	26S	1E

Distance and direction from nearest town or city street address of well if located within city?

5403 N. Broadway, Wichita, KS

2 WATER WELL OWNER: Lewis Williams


RR#, St. Address, Box # North Highway 56

City, State, ZIP Code Moscow, KS

Board of Agriculture, Division of Water Resources

Application Number:

3 MARK WELL'S LOCATION WITH AN "X" IN SECTION BOX:

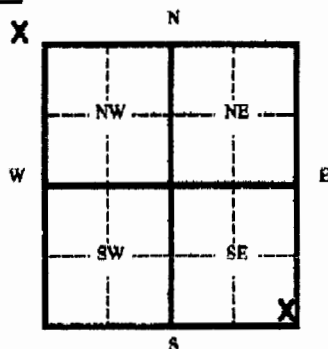

4 DEPTH OF WELL 29.8 ft.

WELL'S STATIC WATER LEVEL 14.3 ft.

WELL WAS USED AS:

1 Domestic

2 Irrigation

3 Feedlot

4 Industrial

5 Public Water Supply

6 Oil Field Water Supply

7 Lawn and Garden (domestic)

8 Air Conditioning

9 Dewatering

10 Monitoring Well

11 Injection Well

12 Other Air Sparge

Was a chemical/bacteriological sample submitted to Department? Yes No

If yes, mo/day/yr sample was submitted

Water Well Disinfected: Yes No

5 TYPE OF BLANK CASING USED:

1 Steel

3 RMP (SR)

5 Wrought

7 Fiberglass

9 Other (specify below)

2 PVC

4 ABC

6 Asbestos-Cement

8 Concrete Tile

Blank casing diameter 2 in.

Was casing pulled? Yes x No

If yes, how much 3 feet

Casing height above or below land surface in.

6 GROUT PLUG MATERIAL: 1 Neat cement 2 Cement grout 3 Bentonite 4 Other

Grout Plug Intervals From ft. to ft. From ft. to ft. From ft. to ft.

What is the nearest source of possible contamination:

1 Septic tank

6 Seepage pit

11 Fuel storage

16 Other (specify below)

2 Sewer lines

7 Pit privy

12 Fertilizer storage

3 Watertight sewer lines

8 Sewage lagoon

13 Insecticide storage

4 Lateral lines

9 Feedyard

14 Abandoned water well

5 Cess Pool

10 Livestock pens

15 Oil well/ Gas well

Direction from well?

How many feet?

FROM	TO	CODE	PLUGGING MATERIALS
0	3		Native materials
3	29.8		Bentonite grout

7 CONTRACTOR'S OR LANDOWNER'S CERTIFICATION: This water well was plugged under my jurisdiction and was completed on (mo/day/yr) 6/17/14 and this record is true to the best of my knowledge and belief. Kansas Water Well Contractor's License No. 6/23/14 This Water Well Record was completed on (mo/day/yr) 6/23/14 under the business name of Bluestem Environmental Engineering, Inc. by (signature) *Nick Ditt*

INSTRUCTIONS: Please fill in blanks and circle the correct answers. Send three copies to Kansas Department of Health and Environment, Bureau of Water, 1000 S W Jackson St., Ste. 420, Topeka, Kansas 66620-0001. Telephone: 785-296-3565. Send one to Water Well Owner and retain one for your records.