

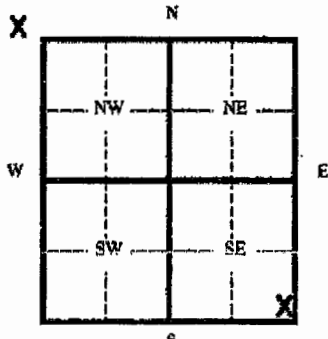
WATER WELL PLUGGING RECORD

Form WWC-5P

KSA 82a-1212

ID No.

MW-20

1 LOCATION OF WATER WELL: County: <u>Sedgwick</u>	Fraction <u>SE 1/4 SE 1/4 SE 1/4</u>	Section Number <u>17</u>	Township Number <u>26S</u>	Range Number <u>1E</u>																																				
Distance and direction from nearest town or city street address of well if located within city? <u>5403 N. Broadway, Wichita, KS</u>	
2 WATER WELL OWNER: <u>Lewis Williams</u> RR#, St. Address, Box # <u>North Highway 56</u> City, State, ZIP Code <u>Moscow, KS</u>	
Board of Agriculture, Division of Water Resources Application Number: _____	
3 MARK WELL'S LOCATION WITH AN "X" IN SECTION BOX: 		4 DEPTH OF WELL <u>21.5</u> ft. WELL'S STATIC WATER LEVEL <u>14</u> ft. WELL WAS USED AS: 1 Domestic 2 Irrigation 3 Feedlot 4 Industrial 5 Public Water Supply 6 Oil Field Water Supply 7 Lawn and Garden (domestic) 8 Air Conditioning 9 Dewatering 10 Monitoring Well 11 Injection Well 12 Other _____ Was a chemical/bacteriological sample submitted to Department? Yes _____ No _____ If yes, mo/day/yr sample was submitted _____ Water Well Disinfected: Yes _____ No _____																																						
5 TYPE OF BLANK CASING USED: 1 Steel 3 RMP (SR) 5 Wrought 7 Fiberglass 9 Other (specify below) _____ 2 PVC 4 ABC 6 Asbestos-Cement 8 Concrete Tile Blank casing diameter <u>4</u> in. Was casing pulled? Yes <u>x</u> No _____ If yes, how much _____ 3 feet Casing height above or below land surface _____ in.	
6 GROUT PLUG MATERIAL: 1 Neat cement 2 Cement grout 3 Bentonite 4 Other _____ Grout Plug Intervals From _____ ft. to _____ ft. From _____ ft. to _____ ft. From _____ ft. to _____ ft. What is the nearest source of possible contamination: 1 Septic tank 2 Sewer lines 3 Watertight sewer lines 4 Lateral lines 5 Cess Pool 6 Seepage pit 7 Pit privy 8 Sewage lagoon 9 Feedyard 10 Livestock pens 11 Fuel storage 12 Fertilizer storage 13 Insecticide storage 14 Abandoned water well 15 Oil well/ Gas well 16 Other (specify below) _____ Direction from well? _____ How many feet? _____	
<table border="1" style="width:100%; border-collapse: collapse;"> <thead> <tr> <th style="width:10%;">FROM</th> <th style="width:10%;">TO</th> <th style="width:10%;">CODE</th> <th style="width:70%;">PLUGGING MATERIALS</th> </tr> </thead> <tbody> <tr> <td>0</td> <td>3</td> <td></td> <td>Native materials</td> </tr> <tr> <td>3</td> <td>21.5</td> <td></td> <td>Bentonite grout</td> </tr> <tr><td> </td><td> </td><td> </td><td> </td></tr> <tr><td> </td><td> </td><td> </td><td> </td></tr> <tr><td> </td><td> </td><td> </td><td> </td></tr> <tr><td> </td><td> </td><td> </td><td> </td></tr> <tr><td> </td><td> </td><td> </td><td> </td></tr> <tr><td> </td><td> </td><td> </td><td> </td></tr> </tbody> </table>					FROM	TO	CODE	PLUGGING MATERIALS	0	3		Native materials	3	21.5		Bentonite grout																								
FROM	TO	CODE	PLUGGING MATERIALS																																					
0	3		Native materials																																					
3	21.5		Bentonite grout																																					
7 CONTRACTOR'S OR LANDOWNER'S CERTIFICATION: This water well was plugged under my jurisdiction and was completed on (mo/day/yr) <u>6/18/14</u> and this record is true to the best of my knowledge and belief. Kansas Water Well Contractor's License No. <u>6/23/14</u> This Water Well Record was completed on (mo/day/yr) _____ by (signature) <u>Nick Holt</u> under the business name of <u>Bluestem Environmental Engineering, Inc.</u>	
INSTRUCTIONS: Please fill in blanks and circle the correct answers. Send three copies to Kansas Department of Health and Environment, Bureau of Water, 1000 S W Jackson St., Ste. 420, Topeka, Kansas 66620-0001. Telephone: 785-296-3585. Send one to Water Well Owner and retain one for your records.	