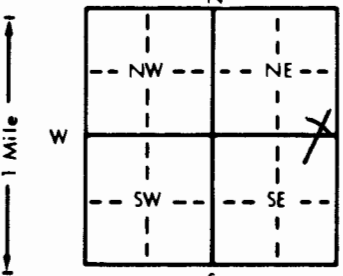


DRY HOLE

1 LOCATION OF WATER WELL:		Fraction	Section Number	Township Number	Range Number
County: <u>Sedgwick</u>		<u>SE 1/4 SE 1/4 NE 1/4</u>	<u>1</u>	T <u>26</u> S	R <u>1</u> E
Distance and direction from nearest town or city street address of well if located within city? <u>1/2 mile North of 69th St. on Woodlawn West side Rd.</u>					
2 WATER WELL OWNER: <u>Vicky Johnson</u>					
RR#, St. Address, Box #: <u>248 SHAWNEE</u>					
City, State, ZIP Code: <u>KECHI, KS, 67067</u>					
Board of Agriculture, Division of Water Resources Application Number:					
3 LOCATE WELL'S LOCATION WITH AN "X" IN SECTION BOX:		4 DEPTH OF COMPLETED WELL: <u>86</u> ft. ELEVATION:			
		WELL WATER TO BE USED AS:			
		5 Public water supply 8 Air conditioning 11 Injection well			
		1 Domestic 3 Feedlot 6 Oil field water supply 9 Dewatering 12 Other (Specify below)			
		2 Irrigation 4 Industrial 7 Lawn and garden only 10 Monitoring well			
5 TYPE OF BLANK CASING USED:					
FROM		TO		LITHOLOGIC LOG	
FROM		TO		PLUGGING INTERVALS	
				<u>86</u> <u>0</u> <u>9/24 fill</u>	
7 CONTRACTOR'S OR LANDOWNER'S CERTIFICATION: This water well was (1) constructed, (2) reconstructed, or (3) plugged under my jurisdiction and was completed on (mo/day/year) <u>Oct 23 88</u> and this record is true to the best of my knowledge and belief. Kansas Water Well Contractor's License No. <u>493</u> This Water Well Record was completed on (mo/day/yr) <u>Nov 9 88</u> under the business name of <u>Reisner Well Drilling</u> by (signature) <u>Tommy Reisner</u>					
INSTRUCTIONS: Use typewriter or ball point pen. PLEASE PRESS FIRMLY and PRINT clearly. Please fill in blanks, underline or circle the correct answers. Send top three copies to Kansas Department of Health and Environment, Bureau of Water Protection, Topeka, Kansas 66620-7320. Telephone: 913-296-5514. Send one to WATER WELL OWNER and retain one for your records.					