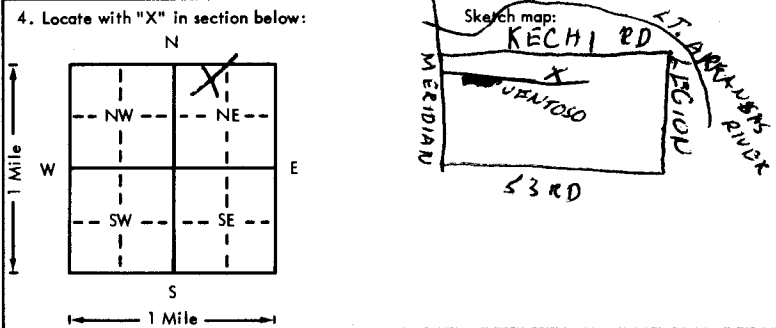


USE TYPEWRITER OR BALL
POINT PEN-PRESS FIRMLY,
PRINT CLEARLY.

WATER WELL RECORD
KSA 82a-1201-1215

Kansas Department of Health and
Environment-Division of Environment
(Water well Contractors)
Topeka, Kansas 66620

NW NW NE NW

1. Location of well:		County Sedgwick	Fraction NE 1/4 NE 1/4 NE 1/4	Section number 18	Township number T 26 S	Range number R 1 EAST
2. Distance and direction from nearest town or city: Street address of well location if in city: 2033 Ventoso				3. Owner of well: Vern Riek R.R. or street: 2033 Ventoso City, state, zip code: Wichita KS		
4. Locate with "X" in section below: 				6. Bore hole dia. 8 in. Completion date 8/6/77 Well depth 30 ft.		
5. Type and color of material				7. <input type="checkbox"/> Cable tool <input checked="" type="checkbox"/> Rotary <input type="checkbox"/> Driven <input type="checkbox"/> Dug <input type="checkbox"/> Hollow rod <input type="checkbox"/> Jetted <input type="checkbox"/> Bored <input type="checkbox"/> Reverse rotary		
				8. Use: <input checked="" type="checkbox"/> Domestic <input type="checkbox"/> Public supply <input type="checkbox"/> Industry <input type="checkbox"/> Irrigation <input type="checkbox"/> Air conditioning <input type="checkbox"/> Stock <input type="checkbox"/> Lawn <input type="checkbox"/> Oil field water <input type="checkbox"/> Other		
				9. Casing: Material styrene Height: Above or below Threaded <input type="checkbox"/> Welded <input type="checkbox"/> Surface 12 in. RMP <input type="checkbox"/> PVC <input type="checkbox"/> Weight 100 lbs./ft. Dia. 4 in. to 30 ft. depth Wall Thickness: inches or Dia. <input type="checkbox"/> in. to <input type="checkbox"/> ft. depth gage No. 100		
				10. Screen: Manufacturer's name Sunflower Type 109 Dia. 4 Slot/gauze 3/16 Length 5 Set between 25 ft. and 30 ft. <input type="checkbox"/> ft. and <input type="checkbox"/> ft. Gravel pack? No Size range of material 4		
				11. Static water level: 15 ft. below land surface Date 8/6/77 mo./day/yr.		
				12. Pumping level below land surfaces: ____ ft. after ____ hrs. pumping ____ g.p.m. ____ ft. after ____ hrs. pumping ____ g.p.m. Estimated maximum yield 10 g.p.m.		
				13. Water sample submitted: ____ mo./day/yr. Yes <input type="checkbox"/> No <input checked="" type="checkbox"/> Date ____		
				14. Well head completion: 12 inches above grade ____ Pitless adapter		
				15. Well grouted? YES With: <input checked="" type="checkbox"/> Neat cement <input type="checkbox"/> Bentonite <input type="checkbox"/> Concrete Depth: From 0 ft. to 10 ft.		
				16. Nearest source of possible contamination: ft. 50 Direction EAST Type SEWER Well disinfected upon completion? <input checked="" type="checkbox"/> Yes <input type="checkbox"/> No		
				17. Pump: <input checked="" type="checkbox"/> Not installed Manufacturer's name ____ Model number ____ HP ____ Volts ____ Length of drop pipe ____ ft. capacity ____ g.p.m. Type: <input type="checkbox"/> Submersible <input type="checkbox"/> Turbine <input type="checkbox"/> Jet <input type="checkbox"/> Reciprocating <input type="checkbox"/> Centrifugal <input type="checkbox"/> Other		
				(Use a second sheet if needed)		
18. Elevation:		19. Remarks:		20. Water well contractor's certification: This well was drilled under my jurisdiction and this report is true to the best of my knowledge and belief. Jet Drilling 313 Business name 257 N. Sakin License No. ____ Address Wichita KS Signed Allegie Hardman Date 8/6/77 Authorized representative		

Forward the white, blue and pink copies to the Department of Health and Environment

Form WWC-5