

WATER WELL RECORD

Form WWC-5

Division of Water Resources App. No.


MW-6

1 LOCATION OF WATER WELL: County: Sedgwick	Fraction SE ¼ SW ¼ SE ¼ ¼	Section Number 33	Township No. T 26 S	Range Number R 1 <input checked="" type="checkbox"/> E <input type="checkbox"/> W
--	------------------------------	----------------------	------------------------	--

Street/Rural Address of Well Location; if unknown, distance & direction from nearest town or intersection: If at owner's address, check here
1025 E. 29th Street N., Wichita, KS 67219

Global Positioning System (GPS) information:
Latitude: 37.739569 (in decimal degrees)
Longitude: -97.326536 (in decimal degrees)
Elevation:
Datum: WGS 84, NAD 83, NAD 27
Collection Method:
 GPS unit (Make/Model: Google Earth)
 Digital Map/Photo, Topographic Map, Land Survey
Est. Accuracy: < 3 m, 3-5 m, 5-15 m, > 15 m

2 WATER WELL OWNER: BNSF
RR#, Street Address, Box #: 4515 Kansas Avenue
City, State, ZIP Code : Kansas City, KS 66106

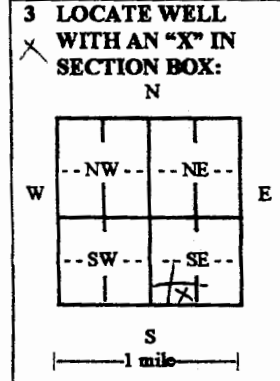

4 DEPTH OF COMPLETED WELL 18.0' ft

Depth(s) Groundwater Encountered (1)..... ft (2)..... ft (3)..... ft

WELL'S STATIC WATER LEVEL 11.72' ft below land surface measured on mo/day/yr. 2/18/16

Pump test data: Well water was..... ft after..... hours pumping..... gpm

EST. YIELD..... gpm Well water was..... ft after..... hours pumping..... gpm

Bore Hole Diameter 8.50" in to 18.0' ft, and in to ft

WELL WATER TO BE USED AS: Public water supply Geothermal Injection well
 Domestic Feedlot Oil field water supply Dewatering Other (Specify below)
 Irrigation Industrial Domestic-lawn & garden Monitoring well

Was a chemical/bacteriological sample submitted to Department? Yes No

If yes, mo/day/yr sample was submitted.....

Water well disinfected? Yes No

5 TYPE OF CASING USED: Steel PVC Other

CASING JOINTS: Glued Clamped Welded Threaded

Casing diameter 2.0" in to 8.0' ft, Diameter in to ft, Diameter in to ft

Casing height above land surface Flush in, Weight lbs./ft., Wall thickness or gauge No. Sch. 40

TYPE OF SCREEN OR PERFORATION MATERIAL:
 Steel Stainless Steel PVC Other (Specify)
 Brass Galvanized Steel None used (open hole)

SCREEN OR PERFORATION OPENINGS ARE:
 Continuous slot Mill slot Gauze wrapped Torch cut Drilled holes None (open hole)
 Louvered shutter Key punched Wire wrapped Saw cut Other (specify)

SCREEN-PERFORATED INTERVALS: From 8.0' ft to 18.0' ft, From ft to ft
From ft to ft, From ft to ft

GRAVEL PACK INTERVALS: From 6.0' ft to 18.0' ft, From ft to ft
From ft to ft, From ft to ft

6 GROUT MATERIAL: Neat cement Cement grout Bentonite Other Concrete

Grout Intervals: From 0 ft to 1.0' ft, From 1.0' ft to 6.0' ft, From ft to ft

What is the nearest source of possible contamination:
 Septic tank Lateral lines Pit privy Livestock pens Insecticide storage Other (specify below)
 Sewer lines Cesspool Sewage lagoon Fuel storage Abandoned water well
 Watertight sewer lines Seepage pit Feedyard Fertilizer storage Oil well/gas well

Direction from well Distance from well

FROM	TO	LITHOLOGIC LOG	FROM	TO	LITHO. LOG (cont.) or PLUGGING INTERVALS
0	9'	Gray Silty Clay			
9	18'	Lz. Brn Fine Sand			
	18'	End of Boring			

Original Returned to Sender
for Correction Date: 7/9/16

7 CONTRACTOR'S OR LANDOWNER'S CERTIFICATION: This water well was constructed, reconstructed, or plugged under my jurisdiction and was completed on (mo/day/year) 02/17/2016 and this record is true to the best of my knowledge and belief. Kansas Water Well Contractor's License No. 606 This Water Well Record was completed on (mo/day/year) 03/10/2016 under the business name of PSA Environmental Services, LLC by (signature)

INSTRUCTIONS: Use typewriter or ball point pen. PLEASE PRESS FIRMLY and PRINT clearly. Please fill in blanks and check the correct answers. Send three copies (white, blue, pink) to Kansas Department of Health and Environment, Bureau of Water, Geology Section, 1000 SW Jackson St., Suite 420, Topeka, Kansas 66612-1367. Telephone 785-296-5522. Send one copy to WATER WELL OWNER and retain one for your records. Include fee of \$5.00 for each constructed well. Visit us at <http://www.kdheks.gov/waterwell/index.html>