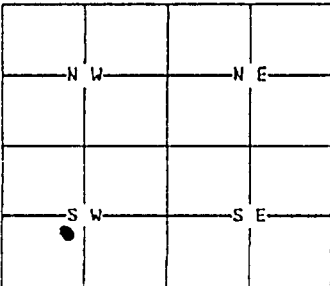


1 LOCATION OF WATER WELL: County: <b>Sedgwick</b>	fraction <b>NE 1/4 SW 1/4 SW 1/4</b>	Section Number <b>16</b>	Township Number <b>26S</b>	Range Number <b>1E</b>
--	---	-----------------------------	-------------------------------	---------------------------

Distance and direction from nearest town or city street address of well if located within city?  
**Approx 150 ft NE of 5402 N. Broadway in Wichita, KS.**

2 WATER WELL OWNER: <b>Allen's Concrete, Inc</b> RR#, St. Address, Bbx #: <b>P.O. Box 4048</b> City, State, ZIP Code : <b>Wichita, Ks. 67204</b>	Board of Agriculture, Division of Water Resources Application Number:
---	--

3 MARK WELL'S LOCATION WITH AN "X" IN SECTION BOX: <div style="text-align: center;">N  <table border="1" style="width:100%; height: 100px; border-collapse: collapse;"> <tr><td style="width:25%;">N W</td><td style="width:25%;">N E</td></tr> <tr><td>W</td><td>E</td></tr> <tr><td>S W</td><td>S E</td></tr> </table>  S  </div>	N W	N E	W	E	S W	S E	4 DEPTH OF WELL..... <b>27</b> ..ft. WELL'S STATIC WATER LEVEL..... <b>9 1/2</b> ..ft.  WELL WAS USED AS: <table style="width:100%;"> <tr> <td>1 Domestic</td> <td>5 Public Water Supply</td> <td>9 Dewatering</td> </tr> <tr> <td>2 Irrigation</td> <td>6 Oil Field Water Supply</td> <td>10 Monitoring Well</td> </tr> <tr> <td>3 Feedlot</td> <td>7 Lawn and Garden Only</td> <td>11 Injection Well</td> </tr> <tr> <td><u>4 Industrial</u></td> <td>8 Air Conditioning</td> <td>12 Other.....</td> </tr> </table> Was a chemical/bacteriological sample submitted to Department? Yes.....No.. <b>X</b> .. If yes, mo/day/yr sample was submitted.....  Water Well Disinfected: Yes..... No.. <b>X</b> ..	1 Domestic	5 Public Water Supply	9 Dewatering	2 Irrigation	6 Oil Field Water Supply	10 Monitoring Well	3 Feedlot	7 Lawn and Garden Only	11 Injection Well	<u>4 Industrial</u>	8 Air Conditioning	12 Other.....
N W	N E																		
W	E																		
S W	S E																		
1 Domestic	5 Public Water Supply	9 Dewatering																	
2 Irrigation	6 Oil Field Water Supply	10 Monitoring Well																	
3 Feedlot	7 Lawn and Garden Only	11 Injection Well																	
<u>4 Industrial</u>	8 Air Conditioning	12 Other.....																	

5 TYPE OF BLANK CASING USED: <table style="width:100%;"> <tr> <td>1 Steel</td> <td>3 RMP (SR)</td> <td>5 Wrought</td> <td>7 Fiberglass</td> <td>9 Other (specify below)</td> </tr> <tr> <td><u>2 PVC</u></td> <td>4 ABS</td> <td>6 Asbestos-Cement</td> <td>8 Concrete Tile</td> <td></td> </tr> </table> Blank casing diameter..... <b>4</b> ..in. Was casing pulled? Yes..... No.. <b>X</b> ... If yes; how much..... Casing height above or below land surface... <b>4 10"</b> below.....in.	1 Steel	3 RMP (SR)	5 Wrought	7 Fiberglass	9 Other (specify below)	<u>2 PVC</u>	4 ABS	6 Asbestos-Cement	8 Concrete Tile	
1 Steel	3 RMP (SR)	5 Wrought	7 Fiberglass	9 Other (specify below)						
<u>2 PVC</u>	4 ABS	6 Asbestos-Cement	8 Concrete Tile							

6 GROUT PLUG MATERIAL: 1 Neat cement <u>2 Cement grout</u> 3 Bentonite 4 Other..... Grout Plug Intervals: From... <b>27</b> ..ft. to <b>grade</b> ..ft., From.....ft. to .....ft., From..... to .....ft. What is the nearest source of possible contamination: <table style="width:100%;"> <tr> <td>1 Septic tank</td> <td>6 Seepage pit</td> <td>11 Fuel storage</td> <td rowspan="5"><u>16 Other (specify below)</u></td> </tr> <tr> <td>2 Sewer lines</td> <td>7 Pit privy</td> <td>12 Fertilizer storage</td> </tr> <tr> <td>3 Watertight sewer lines</td> <td>8 Sewage lagoon</td> <td>13 Insecticide storage</td> </tr> <tr> <td>4 Lateral lines</td> <td>9 Feedyard</td> <td>14 Abandoned water well</td> </tr> <tr> <td>5 Cess Pool</td> <td>10 Livestock pens</td> <td>15 Oil well/Gas well</td> </tr> </table> Direction from well? ..... How many feet? <b>See below</b> .....	1 Septic tank	6 Seepage pit	11 Fuel storage	<u>16 Other (specify below)</u>	2 Sewer lines	7 Pit privy	12 Fertilizer storage	3 Watertight sewer lines	8 Sewage lagoon	13 Insecticide storage	4 Lateral lines	9 Feedyard	14 Abandoned water well	5 Cess Pool	10 Livestock pens	15 Oil well/Gas well
1 Septic tank	6 Seepage pit	11 Fuel storage	<u>16 Other (specify below)</u>													
2 Sewer lines	7 Pit privy	12 Fertilizer storage														
3 Watertight sewer lines	8 Sewage lagoon	13 Insecticide storage														
4 Lateral lines	9 Feedyard	14 Abandoned water well														
5 Cess Pool	10 Livestock pens	15 Oil well/Gas well														

FROM	TO	PLUGGING MATERIALS
27	4	Cement grout
4	0	Compacted soil

NOTE: This well was on railroad R.O.W.; site has been abandoned.

RECEIVED

FEB 04 1998

BUREAU OF WATER

7 CONTRACTOR'S OR LANDOWNER'S CERTIFICATION: This water well was plugged under my jurisdiction and was completed on (mo/day/year)..... <b>2-3-98</b> ..... and this record is true to the best of my knowledge and belief. Kansas Water Well Contractor's License No. .... <b>NA</b> ..... This Water Well Record was completed on (mo/day/year)..... <b>2-3-98</b> ..... under the business name of <b>Allen's Concrete, Inc.</b> by (signature) <u>Phillip E. Brothers</u> <b>Phillip E. Brothers, Production Mgr</b>
--

INSTRUCTIONS: Use typewriter or ball point pen. Please press firmly and print clearly. Please fill in blanks, underline or circle the correct answers. Send top three copies to Kansas Department of Health and Environment, Bureau of Water, Topeka, Kansas 66620-0001. Telephone: 913/296-3565. Send one to Water Well Owner and retain one for your records.