

WATER WELL RECORD Form WWC-5

☒ Original Record ☐ Correction ☐ Change in Well Use

Division of Water
Resources App. No.

Well ID

MW-37

1 LOCATION OF WATER WELL: County: Sedgwick		Fraction SE ¼ NW ¼ SW ¼ SW ¼	Section Number 27	Township Number T 26 S	Range Number R 1 <input checked="" type="checkbox"/> E <input type="checkbox"/> W								
2 WELL OWNER: Last Name: First: Business: USD 259 School Service Center Address: 3850 N. Hydraulic Address: City: Wichita State: KS ZIP: 67219		Street or Rural Address where well is located (if unknown, distance and direction from nearest town or intersection): If at owner's address, check here: <input checked="" type="checkbox"/>											
3 LOCATE WELL WITH "X" IN SECTION BOX: N <div style="text-align: center;"> <table border="1" style="width: 100px; margin: auto;"> <tr><td>--NW--</td><td>--NE--</td></tr> <tr><td>W</td><td>E</td></tr> <tr><td>X--SW--</td><td>--SE--</td></tr> <tr><td colspan="2" style="text-align: center;">S</td></tr> </table> </div>		--NW--	--NE--	W	E	X--SW--	--SE--	S		4 DEPTH OF COMPLETED WELL:33..... ft. Depth(s) Groundwater Encountered: 1)28.2..... ft. 2) ft. 3) ft., or 4) <input type="checkbox"/> Dry Well WELL'S STATIC WATER LEVEL:17.10..... ft. <input checked="" type="checkbox"/> below land surface, measured on (mo-day-yr) 12/12/2016 <input type="checkbox"/> above land surface, measured on (mo-day-yr)..... Pump test data: Well water was ft. after hours pumping gpm Well water was ft. after hours pumping gpm Estimated Yield: gpm Bore Hole Diameter:3.6..... in. to33..... ft. and in. to ft.		5 Latitude: N 37.7545144 (decimal degrees) Longitude: W 97.3162077 (decimal degrees) Horizontal Datum: <input type="checkbox"/> WGS 84 <input checked="" type="checkbox"/> NAD 83 <input type="checkbox"/> NAD 27 <u>Source for Latitude/Longitude:</u> <input type="checkbox"/> GPS (unit make/model:) (WAAS enabled? <input type="checkbox"/> Yes <input type="checkbox"/> No) <input checked="" type="checkbox"/> Land Survey <input type="checkbox"/> Topographic Map <input type="checkbox"/> Online Mapper:	
--NW--	--NE--												
W	E												
X--SW--	--SE--												
S													
		6 Elevation:1330.70..... ft. <input type="checkbox"/> Ground Level <input checked="" type="checkbox"/> TOC <u>Source:</u> <input checked="" type="checkbox"/> Land Survey <input type="checkbox"/> GPS <input type="checkbox"/> Topographic Map <input type="checkbox"/> Other											

7 WELL WATER TO BE USED AS:

- | | | |
|---|---|---|
| 1. Domestic:
<input type="checkbox"/> Household
<input type="checkbox"/> Lawn & Garden
<input type="checkbox"/> Livestock
2. <input type="checkbox"/> Irrigation
3. <input type="checkbox"/> Feedlot
4. <input type="checkbox"/> Industrial | 5. <input type="checkbox"/> Public Water Supply: well ID
6. <input type="checkbox"/> Dewatering: how many wells?
7. <input type="checkbox"/> Aquifer Recharge: well ID
8. <input checked="" type="checkbox"/> Monitoring: well ID MW-37
9. Environmental Remediation: well ID
<input type="checkbox"/> Air Sparge <input type="checkbox"/> Soil Vapor Extraction
<input type="checkbox"/> Recovery <input type="checkbox"/> Injection | 10. <input type="checkbox"/> Oil Field Water Supply: lease
11. Test Hole: well ID
<input type="checkbox"/> Cased <input type="checkbox"/> Uncased <input type="checkbox"/> Geotechnical
12. Geothermal: how many bores?
a) Closed Loop <input type="checkbox"/> Horizontal <input type="checkbox"/> Vertical
b) Open Loop <input type="checkbox"/> Surface Discharge <input type="checkbox"/> Inj. of Water
13. <input type="checkbox"/> Other (specify): |
|---|---|---|

Was a chemical/bacteriological sample submitted to KDHE? ☐ Yes ☒ No If yes, date sample was submitted:
Water well disinfected? ☐ Yes ☒ No

8 TYPE OF CASING USED: ☐ Steel ☒ PVC ☐ Other **CASING JOINTS:** ☐ Glued ☐ Clamped ☐ Welded ☐ Threaded
 Casing diameter1.5..... in. to ft., Diameter in. to ft., Diameter in. to ft.
 Casing height above land surface0..... in. Weight lbs./ft. Wall thickness or gauge No. 40.....

TYPE OF SCREEN OR PERFORATION MATERIAL:

- ☐ Steel ☐ Stainless Steel ☐ Fiberglass ☒ PVC ☐ Other (Specify)
☐ Brass ☐ Galvanized Steel ☐ Concrete tile ☐ None used (open hole)

SCREEN OR PERFORATION OPENINGS ARE:

- ☐ Continuous Slot ☒ Mill Slot ☐ Gauze Wrapped ☐ Torch Cut ☐ Drilled Holes ☐ Other (Specify)
☐ Louvered Shutter ☐ Key Punched ☐ Wire Wrapped ☐ Saw Cut ☐ None (Open Hole)

SCREEN-PERFORATED INTERVALS: From .23..... ft. to .33..... ft., From ft. to ft., From ft. to ft.

GRAVEL PACK INTERVALS: From20..... ft. to33..... ft., From ft. to ft., From ft. to ft.

9 GROUT MATERIAL: ☐ Neat cement ☐ Cement grout ☒ Bentonite ☐ Other
 Grout Intervals: From1..... ft. to20..... ft., From ft. to ft., From ft. to ft.

Nearest source of possible contamination:

- | | | | | |
|---|--|--|---|---|
| <input type="checkbox"/> Septic Tank | <input type="checkbox"/> Lateral Lines | <input type="checkbox"/> Pit Privy | <input type="checkbox"/> Livestock Pens | <input type="checkbox"/> Insecticide Storage |
| <input type="checkbox"/> Sewer Lines | <input type="checkbox"/> Cess Pool | <input type="checkbox"/> Sewage Lagoon | <input type="checkbox"/> Fuel Storage | <input type="checkbox"/> Abandoned Water Well |
| <input type="checkbox"/> Watertight Sewer Lines | <input type="checkbox"/> Seepage Pit | <input type="checkbox"/> Feedyard | <input type="checkbox"/> Fertilizer Storage | <input type="checkbox"/> Oil Well/Gas Well |
- ☒ Other (Specify) Former USTs

Direction from well? East Distance from well? 425..... ft.

10 FROM	TO	LITHOLOGIC LOG	FROM	TO	LITHO. LOG (cont.) or PLUGGING INTERVALS
0	24.6	Clay, dk brn to brn, trace silt & snd			
24.6	25.7	Sand, brn, clayey, fn			
25.7	28.2	Clay, grn brn, little fn snd & silt			
28.2	31.3	Sand, brn, med to crs			
31.3	33	Shale, weathered, gry			

Notes:

11 CONTRACTOR'S OR LANDOWNER'S CERTIFICATION: This water well was ☒ constructed, ☐ reconstructed, or ☐ plugged under my jurisdiction and was completed on (mo-day-year) 12-06-2016.... and this record is true to the best of my knowledge and belief. Kansas Water Well Contractor's License No. 531..... This Water Well Record was completed on (mo-day-year) 01-04-2017..... under the business name of GSI Engineering, LLC..... Signature


Mail 1 white copy along with a fee of \$5.00 for each constructed well to: Kansas Department of Health and Environment, Bureau of Water, GWTS Section, 1000 SW Jackson St., Suite 420, Topeka, Kansas 66612-1367. Mail one to Water Well Owner and retain one for your records. Telephone 785-296-5524.

Visit us at <http://www.kdheks.gov/waterwell/index.html>





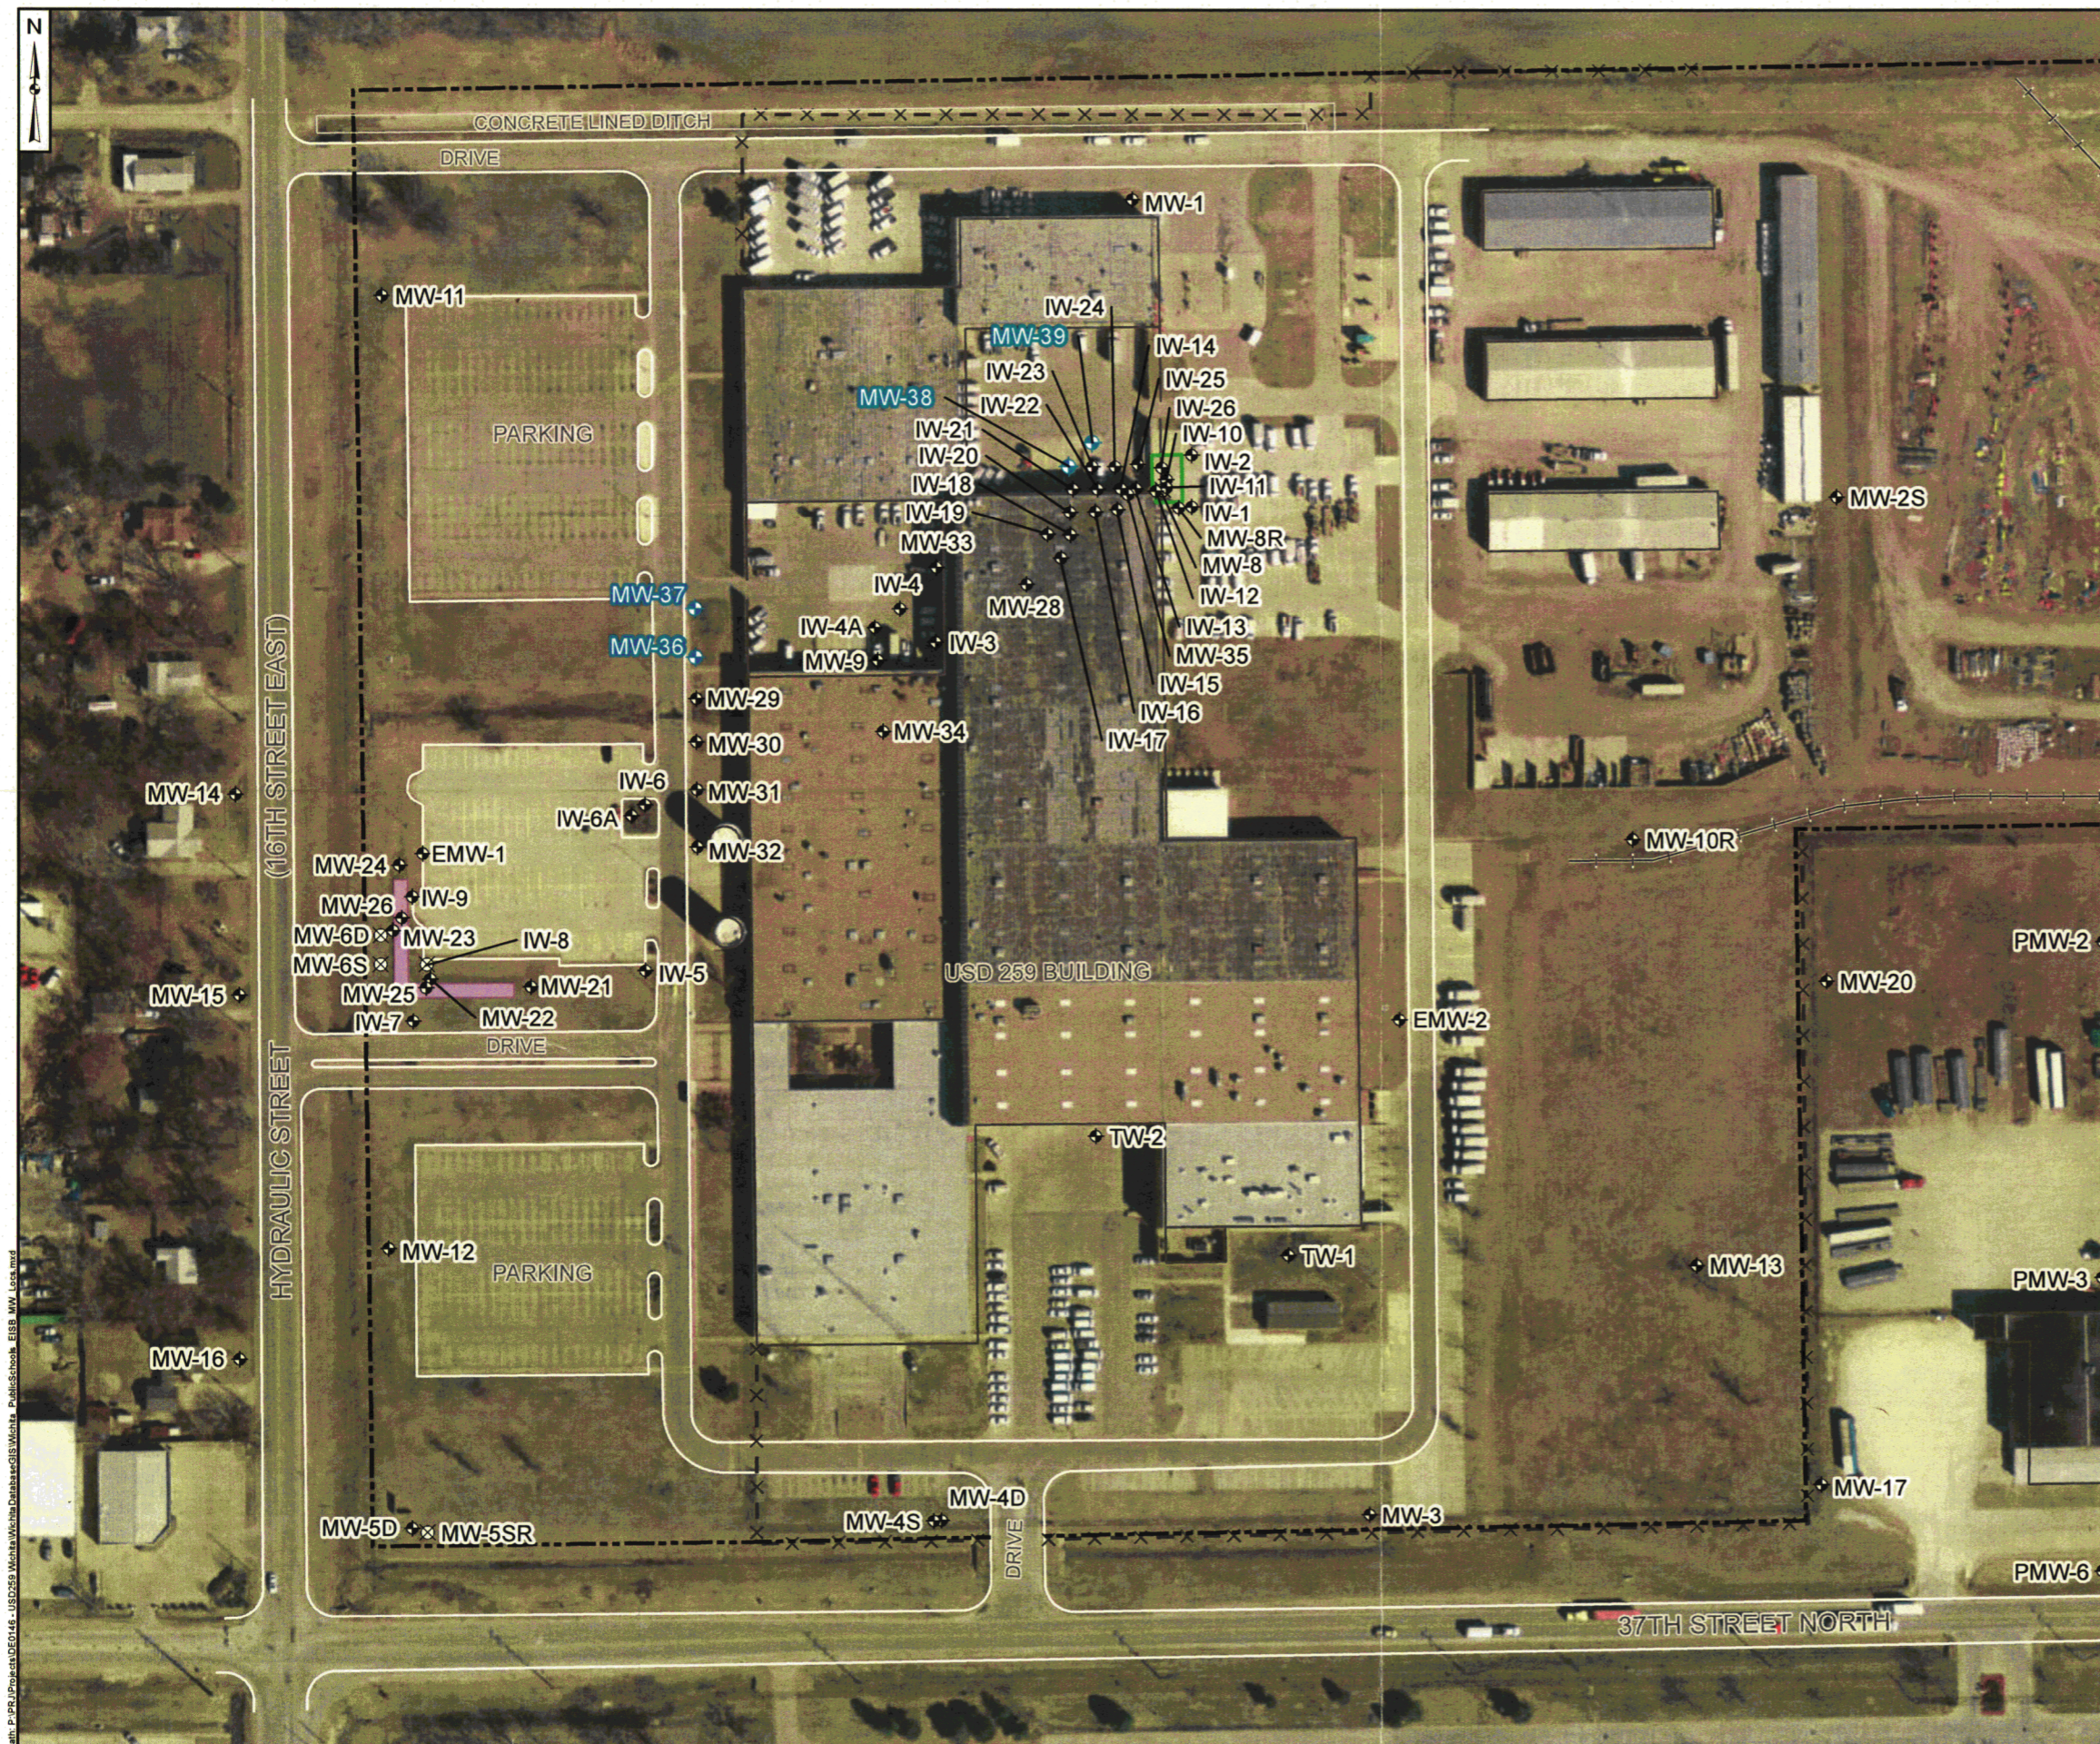

KSA 82a-1212

Revised 7/10/2015

sec 27 T26 R1E



Legend

-  New Monitoring Well Location (December 2016)
 Well Location
 Abandoned or Destroyed Well
 Former Excavation to Remove Underground Storage Tanks
 Permeable Reactive Barrier (PRB)
 Property Boundary

Notes:

1. Site features, property boundaries, and well locations are approximate and are not of legal land survey.
2. Some well locations were surveyed by Merestone Surveying. Nov. 7, 2014. Coordinate system is NAD83, KS South, State Plane Zone 1502, US Survey Foot format (refer to Table 2 for survey dates).
3. Basemap source: Golder Associates, drawing titled: "Potentiometric Surface Elevation Map April 2013", dated August, 26, 2013, Figure Number 1, File No. 12384321, Revision 1 (Draft) and modified by Geosyntec in December 2014.
4. Imagery source: Esri, DigitalGlobe, GeoEye, Earthstar Geographics, CNES/Airbus DS, USDA, USGS, AEX, Getmapping, Aerogrid, IGN, IGP, swisstopo, and the GIS User Community.
5. Coordinate system is NAD83, KS South, State Plane Zone 1502, US Survey Foot format

Location	Easting	Northing
MW-36	1654563.51	1710614.96
MW-37	1654562.90	1710656.81
MW-38	1654882.30	1710779.08
MW-39	1654902.37	1710799.60

08 RECEIVED

JAN 09 2017

BUREAU OF WATER



New and Existing Monitoring Well Locations

USD259 School Service Center, Wichita, Kansas

Geosyntec 
consultants

Guelph

December 2016

Figure

1