

# WATER WELL PLUGGING RECORD Form WWC-5P

KSA 82a-1212

ID NO.

MW-12

|  |                                 |                     |                           |  |
|--|---------------------------------|---------------------|---------------------------|--|
| <b>1 LOCATION OF WATER WELL:</b><br>County: Sedgwick | Fraction<br>NW ¼ NE ¼ NE ¼ SW ¼ | Section Number<br>8 | Township Number<br>T 26 S | Range Number<br>1 <input checked="" type="checkbox"/> E <input type="checkbox"/> W |
|--|---------------------------------|---------------------|---------------------------|--|

Street/Rural Address of Well Location; if unknown, distance & direction from nearest town or intersection: If at owner's address, check here ☐ Approximately one-half mile west of the intersection of 61st Street and Broadway Street


## Global Positioning Systems (GPS) information:

Latitude: 37.8030412 (in decimal degrees)  
Longitude: -097.3453957 (in decimal degrees)  
Elevation: 1,337.33  
Horizontal Datum: ☒ WGS84, ☐ NAD83, ☐ NAD27  
Collection Method:

**2 WATER WELL OWNER:** El Paso Merchant Energy-PC  
RR#, St. Address, Box #: 2 N. Nevada Ave  
City, State ZIP Code: Colorado Springs, CO 80903

☐ GPS unit (Make/Model: \_\_\_\_\_)  
☐ Digital Map/Photo, ☐ Topographic Map, ☐ Land Survey  
Est. Accuracy: ☒ < 3 m, ☐ 3-5 m, ☐ 5-15 m, ☐ > 15 m

## 3 MARK WELL'S LOCATION WITH AN "X" IN SECTION BOX:

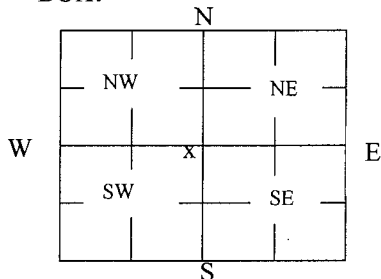

## 4 DEPTH OF WELL 25.95 ft.

WELL'S STATIC WATER LEVEL 17.33 ft

### WELL WAS USED AS:

- |                                     |   |  |
|-------------------------------------|---|--|
| <input type="checkbox"/> Domestic   | <input type="checkbox"/> Public Water Supply      | <input type="checkbox"/> Dewatering            |
| <input type="checkbox"/> Irrigation | <input type="checkbox"/> Oil Field Water Supply   | <input checked="" type="checkbox"/> Monitoring |
| <input type="checkbox"/> Feedlot    | <input type="checkbox"/> Domestic (Lawn & Garden) | <input type="checkbox"/> Injection Well        |
| <input type="checkbox"/> Industrial | <input type="checkbox"/> Air Conditioning         | <input type="checkbox"/> Other _____           |

Was a chemical/bacteriological sample submitted to Department? Yes ☐ No ☒

## 5 TYPE OF BLANK CASING USED:

- ☐ Steel ☐ RMP (SR) ☐ Wrought ☐ Fiberglass ☐ Other (Specify below) \_\_\_\_\_  
☒ PVC ☐ ABS ☐ Asbestos-Cement ☐ Concrete Tile

Blank casing diameter 2" in. Was casing pulled? Yes ☒ No ☐ If yes, how much 2' ags & 3' bgs  
Casing height above or below land surface 27" ags in.

## 6 GROUT PLUG MATERIAL:

- ☐ Neat cement ☐ Cement grout ☒ Bentonite ☐ Other \_\_\_\_\_

Grout Plug Intervals: From 25.95 ft. to 3.0 ft., From \_\_\_\_\_ ft. to \_\_\_\_\_ ft., From \_\_\_\_\_ ft. to \_\_\_\_\_ ft.

What is the nearest source of possible contamination:

- |   |   |   |  |
|---|---|---|--|
| <input type="checkbox"/> Septic tank            | <input type="checkbox"/> Seepage pit    | <input type="checkbox"/> Fuel storage         | <input type="checkbox"/> Other (specify below) _____ |
| <input type="checkbox"/> Sewer lines            | <input type="checkbox"/> Pit privy      | <input type="checkbox"/> Fertilizer storage   |  |
| <input type="checkbox"/> Watertight sewer lines | <input type="checkbox"/> Sewage lagoon  | <input type="checkbox"/> Insecticide storage  |  |
| <input type="checkbox"/> Lateral lines          | <input type="checkbox"/> Feedyard       | <input type="checkbox"/> Abandoned water well |  |
| <input type="checkbox"/> Cess pool              | <input type="checkbox"/> Livestock pens | <input type="checkbox"/> Oil well/Gas well    |  |
- Direction from well? \_\_\_\_\_  
How many feet? \_\_\_\_\_

| FROM  | TO  | PLUGGING MATERIALS         | FROM | TO | PLUGGING MATERIALS |
|-------|-----|----------------------------|------|----|--------------------|
| 25.95 | 3.0 | Bentonite chips (Hydrated) |      |    |                    |
| 3.0   | 0.0 | Native soil/topsoil        |      |    |                    |
|       |     |                            |      |    |                    |
|       |     |                            |      |    |                    |
|       |     |                            |      |    |                    |
|       |     |                            |      |    |                    |

**7 CONTRACTOR'S OR LANDOWNER'S CERTIFICATION:** This water well was plugged under my jurisdiction and was completed on (mo/day/year) 7/26/2018 and this record is true to the best of my knowledge and belief. Kansas Water Well Contractor's License No. \_\_\_\_\_. This Water Well Record was completed on (mo/day/year) 9/13/2018 under the business name of Stantec by (signature) *Cristy H. Miller P.E.*

Send one white copy to Kansas Department of Health & Environment, Geology Section, 1000 SW Jackson Street, Ste. 420, Topeka, KS 66612-1367. Send one copy to WATER WELL OWNER and retain one for your records.  
Visit us at <http://www.kdheks.gov/waterwell/index.html> Telephone 785-296-5524.