

WATER WELL PLUGGING RECORD Form WWC-5P

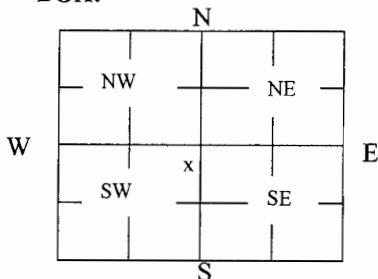
KSA 82a-1212

ID NO.

AS-09 (East)

1 LOCATION OF WATER WELL: County: Sedgwick	Fraction SE ¼ NE ¼ NE ¼ SW ¼	Section Number 8	Township Number T 26 S	Range Number 1 <input checked="" type="checkbox"/> E <input type="checkbox"/> W
Street/Rural Address of Well Location; if unknown, distance & direction from nearest town or intersection: If at owner's address, check here <input type="checkbox"/> Approximately one-half mile west of the intersection of 61st Street and Broadway Street		Global Positioning Systems (GPS) information: Latitude: 37.8020583 (in decimal degrees) Longitude: -097.3452185 (in decimal degrees) Elevation: 1,336.18 Horizontal Datum: <input checked="" type="checkbox"/> WGS84, <input type="checkbox"/> NAD83, <input type="checkbox"/> NAD27 Collection Method:		

2 WATER WELL OWNER: El Paso Merchant Energy-PC RR#, St. Address, Box #: 2 N. Nevada Ave City, State ZIP Code: Colorado Springs, CO 80903	<input type="checkbox"/> GPS unit (Make/Model: _____) <input type="checkbox"/> Digital Map/Photo, <input type="checkbox"/> Topographic Map, <input checked="" type="checkbox"/> Land Survey Est. Accuracy: <input checked="" type="checkbox"/> < 3 m, <input type="checkbox"/> 3-5 m, <input type="checkbox"/> 5-15 m, <input type="checkbox"/> > 15 m
---	--

3 MARK WELL'S LOCATION WITH AN "X" IN SECTION BOX:**4 DEPTH OF WELL** 29.70 **ft.**WELL'S STATIC WATER LEVEL 16.43 **ft**

WELL WAS USED AS:

- ☐
- Domestic
-
- ☐
- Irrigation
-
- ☐
- Feedlot
-
- ☐
- Industrial

- ☐
- Public Water Supply
-
- ☐
- Oil Field Water Supply
-
- ☐
- Domestic (Lawn & Garden)
-
- ☐
- Air Conditioning

- ☐
- Dewatering
-
- ☐
- Monitoring
-
- ☐
- Injection Well
-
- ☒
- Other Air Sparge

Was a chemical/bacteriological sample submitted to Department? Yes ☐ No ☒**5 TYPE OF BLANK CASING USED:**

- ☐
- Steel
- ☐
- RMP (SR)
- ☐
- Wrought
- ☐
- Fiberglass
- ☐
- Other (Specify below)
-
- ☒
- PVC
- ☐
- ABS
- ☐
- Asbestos-Cement
- ☐
- Concrete Tile

 Blank casing diameter 1" in. Was casing pulled? Yes ☒ No ☐ If yes, how much 3' bgs
 Casing height above or below land surface 36" in.
6 GROUT PLUG MATERIAL:

- ☐
- Neat cement
- ☐
- Cement grout
- ☒
- Bentonite
- ☐
- Other

Grout Plug Intervals: From 29.70 ft. to 3.0 ft., From _____ ft. to _____ ft., From _____ ft. to _____ ft.

What is the nearest source of possible contamination:

- | | | | |
|---|---|---|--|
| <input type="checkbox"/> Septic tank | <input type="checkbox"/> Seepage pit | <input type="checkbox"/> Fuel storage | <input type="checkbox"/> Other (specify below) _____ |
| <input type="checkbox"/> Sewer lines | <input type="checkbox"/> Pit privy | <input type="checkbox"/> Fertilizer storage | |
| <input type="checkbox"/> Watertight sewer lines | <input type="checkbox"/> Sewage lagoon | <input type="checkbox"/> Insecticide storage | |
| <input type="checkbox"/> Lateral lines | <input type="checkbox"/> Feedyard | <input type="checkbox"/> Abandoned water well | |
| <input type="checkbox"/> Cess pool | <input type="checkbox"/> Livestock pens | <input type="checkbox"/> Oil well/Gas well | |

 Direction from well? _____
 How many feet? _____

FROM	TO	PLUGGING MATERIALS	FROM	TO	PLUGGING MATERIALS
29.70	3.0	Bentonite chips (Hydrated)			
3.0	0.0	Native soil/topsoil			

7 CONTRACTOR'S OR LANDOWNER'S CERTIFICATION: This water well was plugged under my jurisdiction and was completed on (mo/day/year) 7/26/2018 and this record is true to the best of my knowledge and belief. Kansas Water Well Contractor's License No. _____. This Water Well Record was completed on (mo/day/year) 9/13/2018 under the business name of Stantec by (signature) *[Signature]*

Send one white copy to Kansas Department of Health & Environment, Geology Section, 1000 SW Jackson Street, Ste. 420, Topeka, KS 66612-1367. Send one copy to WATER WELL OWNER and retain one for your records.

 Visit us at <http://www.kdheks.gov/waterwell/index.html> Telephone 785-296-5524.