

WATER WELL PLUGGING RECORD Form WWC-5P

KSA 82a-1212 ID NO.

SVE-05 (West)

1 LOCATION OF WATER WELL: Fraction SW 1/4 NE 1/4 NE 1/4 SW 1/4 Section Number 8 Township Number T 26 S Range Number 1 E W
 County: Sedgwick


Street/Rural Address of Well Location; if unknown, distance & direction from nearest town or intersection: If at owner's address, check here Approximately one-half mile west of the intersection of 61st Street and Broadway Street

Global Positioning Systems (GPS) information:
 Latitude: 37.8014911 (in decimal degrees)
 Longitude: -097.3463682 (in decimal degrees)
 Elevation: 1,335.61
 Horizontal Datum: WGS84, NAD83, NAD27
 Collection Method:

2 WATER WELL OWNER: El Paso Merchant Energy-PC
 RR#, St. Address, Box #: 2 N. Nevada Ave
 City, State ZIP Code: Colorado Springs, CO 80903

GPS unit (Make/Model): _____
 Digital Map/Photo, Topographic Map, Land Survey
 Est. Accuracy: < 3 m, 3-5 m, 5-15 m, > 15 m

3 MARK WELL'S LOCATION WITH AN "X" IN SECTION BOX:

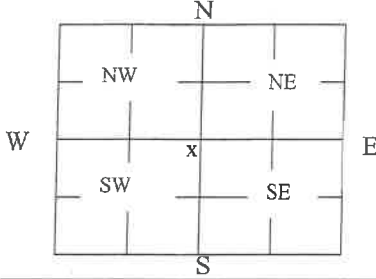

4 DEPTH OF WELL 12.08 ft.

WELL'S STATIC WATER LEVEL N/A ft

WELL WAS USED AS:

- Domestic
- Irrigation
- Feedlot
- Industrial
- Public Water Supply
- Oil Field Water Supply
- Domestic (Lawn & Garden)
- Air Conditioning
- Dewatering
- Monitoring
- Injection Well
- Other SVE Well

Was a chemical/bacteriological sample submitted to Department? Yes No

5 TYPE OF BLANK CASING USED:

- Steel
- RMP (SR)
- Wrought
- Fiberglass
- Other (Specify below) _____
- PVC
- ABS
- Asbestos-Cement
- Concrete Tile

Blank casing diameter 2" in. Was casing pulled? Yes No If yes, how much 3' bgs
 Casing height above or below land surface 36" bgs in.

6 GROUT PLUG MATERIAL: Neat cement Cement grout Bentonite Other _____

Grout Plug Intervals: From 12.08 ft. to 3.0 ft., From _____ ft. to _____ ft., From _____ ft. to _____ ft.

What is the nearest source of possible contamination:

- Septic tank
 - Sewer lines
 - Watertight sewer lines
 - Lateral lines
 - Cess pool
 - Seepage pit
 - Pit privy
 - Sewage lagoon
 - Feedyard
 - Livestock pens
 - Fuel storage
 - Fertilizer storage
 - Insecticide storage
 - Abandoned water well
 - Oil well/Gas well
 - Other (specify below) _____
- Direction from well? _____
 How many feet? _____

FROM	TO	PLUGGING MATERIALS	FROM	TO	PLUGGING MATERIALS
12.08	3.0	Bentonite chips (hydrated)			
3.0	0.0	Native soils/topsoils			

7 CONTRACTOR'S OR LANDOWNER'S CERTIFICATION: This water well was plugged under my jurisdiction and was completed on (mo/day/year) 7/26/2018 and this record is true to the best of my knowledge and belief. Kansas Water Well Contractor's License No. _____. This Water Well Record was completed on (mo/day/year) 9/13/2018 under the business name of Stantec by (signature) Cristy H. Anderson P.E.

Send one white copy to Kansas Department of Health & Environment, Geology Section, 1000 SW Jackson Street, Ste. 420, Topeka, KS 66612-1367. Send one copy to WATER WELL OWNER and retain one for your records.
 Visit us at <http://www.kdheks.gov/waterwell/index.html> Telephone 785-296-5524.