WATER WELL RECORD Form WWC-5

☑ Original Record ☐ Correction ☐ Change in Well Use

Division of Water Resources App. No. _____ Well ID MW-15

1 LOCATION OF WATER WELL: County: Sedgwick | Fraction ¼ ¼ ¼ ¼ | Section Number 16 | Township Number T 26 S | Range Number R 1 ☑ E ☐ W

2 WELL OWNER: Last Name: First:
Business: KDHE BER
Address: 1000 SW Jackson St., Ste. 410
Address:
City: Topeka State: KS ZIP: 66612

Street or Rural Address where well is located (if unknown, distance and direction from nearest town or intersection): If at owner's address, check here: ☐
Approx. 25' S of SW corner of Waste Link office building; 5720 N. Broadway - Wichita, KS

3 LOCATE WELL WITH "X" IN SECTION BOX:

N
- - NW - - | - - NE - -
W | E
- - SW - - | - - SE - -
S
|----------1 mile---------|

4 DEPTH OF COMPLETED WELL: 20 ft.
Depth(s) Groundwater Encountered: 1) 14 ft. 2) 13.2 ft. 3) ..... ft., or 4) ☐ Dry Well
WELL'S STATIC WATER LEVEL: 12.91 ft.
☑ below land surface, measured on (mo-day-yr) 01/31/2019
☐ above land surface, measured on (mo-day-yr).....
Pump test data: Well water was ..... ft. after..... hours pumping ..... gpm
Well water was ..... ft. after..... hours pumping ..... gpm
Estimated Yield: .....gpm
Bore Hole Diameter: 8.25 in. to 20 ft. and ..... in. to ..... ft.

5 Latitude: 37.78661 (decimal degrees)
Longitude: 97.33569 (decimal degrees)
Datum: ☐ WGS 84 ☑ NAD 83 ☐ NAD 27
Source for Latitude/Longitude:
☐ GPS (unit make/model: .....)
(WAAS enabled? ☐ Yes ☐ No)
☑ Land Survey ☐ Topographic Map
☐ Online Mapper: .....

6 Elevation: 1333.93 ft. ☐ Ground Level ☑ TOC
Source: ☑ Land Survey ☐ GPS ☐ Topographic Map
☐ Other .....

7 WELL WATER TO BE USED AS:
1. Domestic: ☐ Household ☐ Lawn & Garden ☐ Livestock
2. ☐ Irrigation
3. ☐ Feedlot
4. ☐ Industrial
5. ☐ Public Water Supply: well ID .....
6. ☐ Dewatering: how many wells? .....
7. ☐ Aquifer Recharge: well ID .....
8. ☑ Monitoring: well ID MW-15
9. Environmental Remediation: well ID ..... ☐ Air Sparge ☐ Soil Vapor Extraction ☐ Recovery ☐ Injection
10. ☐ Oil Field Water Supply: lease .....
11. Test Hole: well ID ..... ☐ Cased ☐ Uncased ☐ Geotechnical
12. Geothermal: how many bores? ..... a) Closed Loop ☐ Horizontal ☐ Vertical b) Open Loop ☐ Surface Discharge ☐ Inj. of Water
13. ☐ Other (specify): .....

Was a chemical/bacteriological sample submitted to KDHE? ☐ Yes ☑ No If yes, date sample was submitted: .....
Water well disinfected? ☐ Yes ☑ No

8 TYPE OF CASING USED: ☐ Steel ☑ PVC ☐ Other ..... CASING JOINTS: ☐ Glued ☐ Clamped ☑ Welded ☐ Threaded
Casing diameter 2 in. to 10 ft., Diameter ..... in. to ..... ft., Diameter ..... in. to ..... ft.
Casing height above land surface 0 in. Weight ..... lbs./ft. Wall thickness or gauge No. 40

TYPE OF SCREEN OR PERFORATION MATERIAL:
☐ Steel ☐ Stainless Steel ☐ Fiberglass ☑ PVC ☐ Other (Specify) .....
☐ Brass ☐ Galvanized Steel ☐ Concrete tile ☐ None used (open hole)

SCREEN OR PERFORATION OPENINGS ARE:
☐ Continuous Slot ☑ Mill Slot ☐ Gauze Wrapped ☐ Torch Cut ☐ Drilled Holes ☐ Other (Specify) .....
☐ Louvered Shutter ☐ Key Punched ☐ Wire Wrapped ☐ Saw Cut ☐ None (Open Hole)

SCREEN-PERFORATED INTERVALS: From 10 ft. to 20 ft., From ..... ft. to ..... ft., From ..... ft. to ..... ft.
GRAVEL PACK INTERVALS: From 7.5 ft. to 20 ft., From ..... ft. to ..... ft., From ..... ft. to ..... ft.

9 GROUT MATERIAL: ☐ Neat cement ☐ Cement grout ☑ Bentonite ☐ Other .....
Grout Intervals: From 1 ft. to 7.5 ft., From ..... ft. to ..... ft., From ..... ft. to ..... ft.

Nearest source of possible contamination: ✔ No potential source of contamination within 200 ft.
☐ Septic Tank ☐ Lateral Lines ☐ Pit Privy ☐ Livestock Pens ☐ Insecticide Storage
☐ Sewer Lines ☐ Cess Pool ☐ Sewage Lagoon ☐ Fuel Storage ☐ Abandoned Water Well
☐ Watertight Sewer Lines ☐ Seepage Pit ☐ Feedyard ☐ Fertilizer Storage ☐ Oil Well/Gas Well
☐ Other (Specify) .....
Direction from well? ..... Distance from well? ..... ft.

10 FROM	TO	LITHOLOGIC LOG	FROM	TO	LITHO. LOG (cont.) or PLUGGING INTERVALS
0	0.5	Concrete			
0.5	12.5	Lean Clay, dk gry, silty			
12.5	20	Prly Grd Sand w/ Clay, m			
			Notes:		

11 CONTRACTOR'S OR LANDOWNER'S CERTIFICATION: This water well was ☑ constructed, ☐ reconstructed, or ☐ plugged under my jurisdiction and was completed on (mo-day-year) 01/23/2019 and this record is true to the best of my knowledge and belief. Kansas Water Well Contractor's License No. 531 This Water Well Record was completed on (mo-day-year) 02/14/2019 under the business name of GSI Engineering, LLC

Send one copy to WATER WELL OWNER and retain one for your records. Fee of $5.00 for each constructed well.
KS Department of Health and Environment, Bureau of Water, Geology Section, 1000 SW Jackson St., Suite 420, Topeka, Kansas 66612-1367. Telephone 785-296-3565.
Visit us at http://www.kdheks.gov/waterwell/index.html KSA 82a-1212

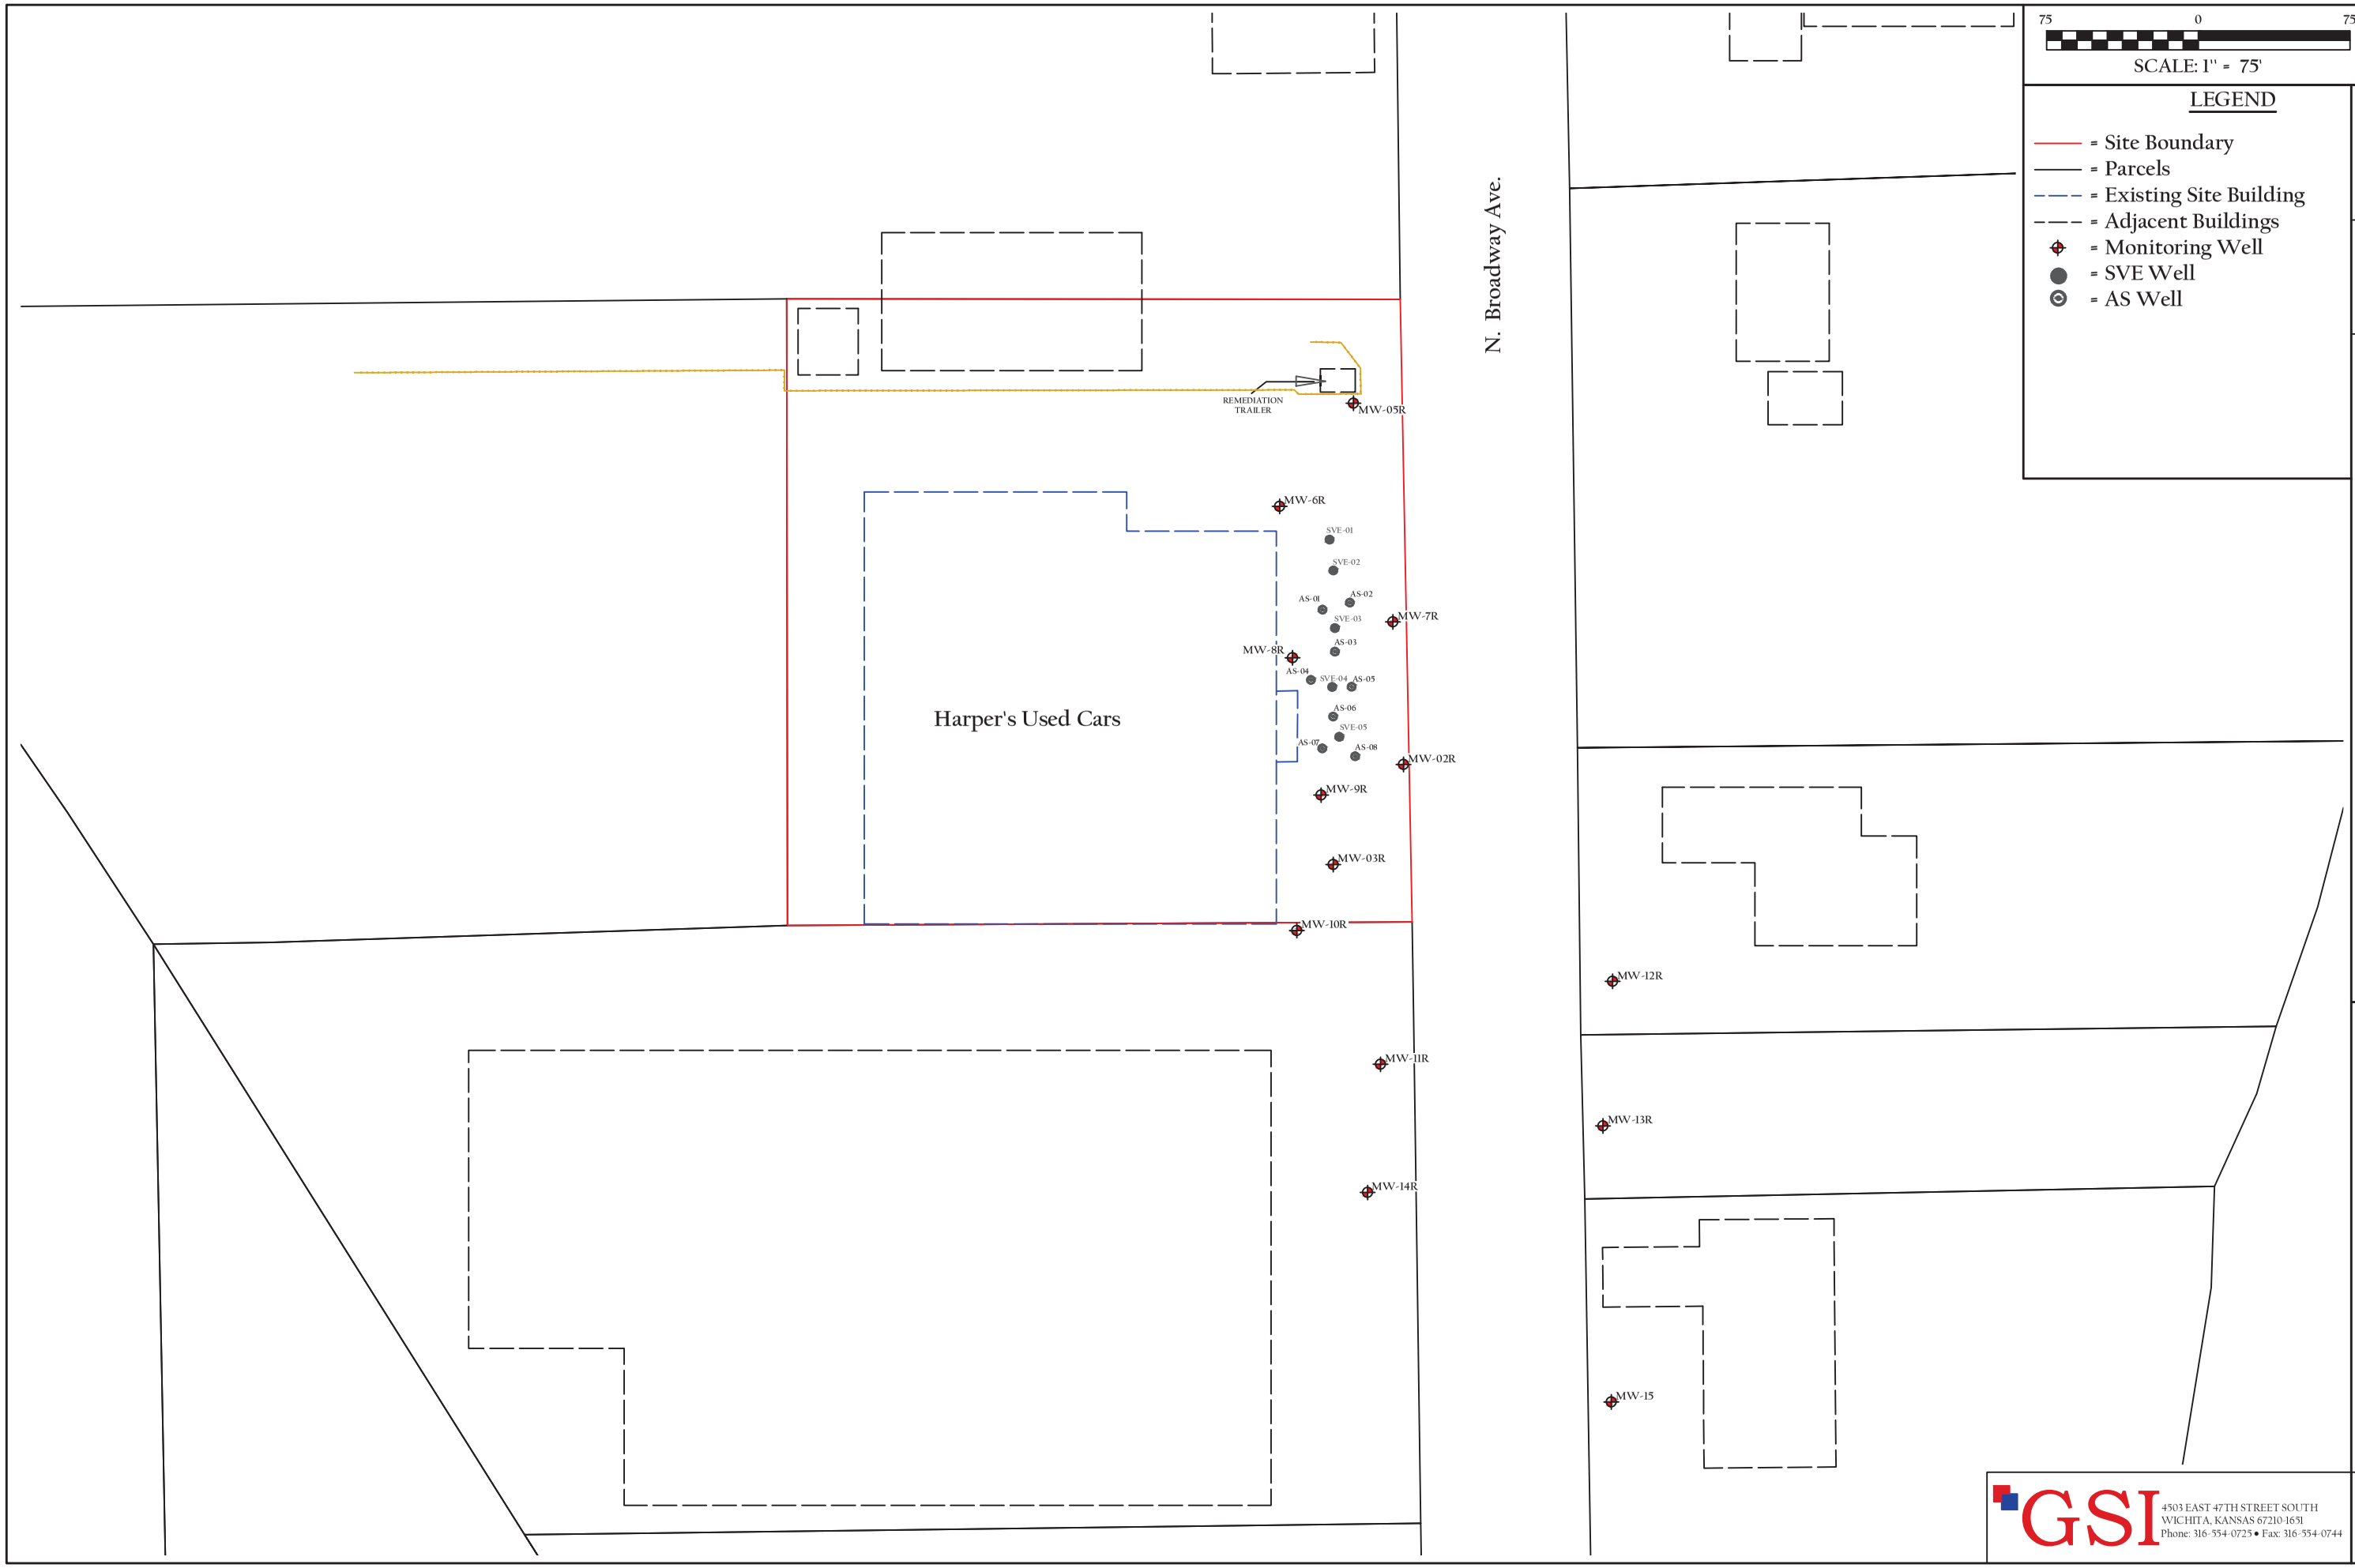
N. Broadway Ave.
Harper's Used Cars
REMEDIATION TRAILER
MW-05R
MW-6R
SVE-01
SVE-02
AS-01
AS-02
SVE-03
MW-7R
AS-03
MW-8R
AS-04
SVE-04
AS-05
AS-06
SVE-05
AS-07
AS-08
MW-02R
MW-9R
MW-03R
MW-10R
MW-11R
MW-14R
MW-12R
MW-13R
MW-15
75
0
75
SCALE: 1" = 75'
N
LEGEND
= Site Boundary
= Parcels
= Existing Site Building
= Adjacent Buildings
= Monitoring Well
= SVE Well
= AS Well
DRAWN BY: CD
PROJ. MANGR: SE
JOB#: 147353
DATE: 2019-02-13
Harper's Used Cars
5725 N. Broadway Ave.
Wichita, Kansas
SITE BASE MAP
GSI
4503 EAST 47TH STREET SOUTH
WICHITA, KANSAS 67210-1651
Phone: 316-554-0725 • Fax: 316-554-0744
FIGURE
1