

WATER WELL PLUGGING RECORD Form WWC-5P
KSA 82a-1212
ID NO.
MW 25

1 LOCATION OF WATER WELL: County: <u>Sedgewick</u>	Fraction <u>1/4 NE 1/4 SW 1/4 NE 1/4</u>	Section Number <u>27</u>	Township Number <u>T 26 S</u>	Range Number <u>1</u> <input checked="" type="checkbox"/> E <input type="checkbox"/> W
--	---	-----------------------------	----------------------------------	---

 Street/Rural Address of Well Location; if unknown, distance & direction from nearest town or intersection: If at owner's address, check here ☐

Phillips 66
420 S. Keeler (1708-02)
Bartlesville, OK 74004

Global Positioning Systems (GPS) information:

 Latitude: 37.76184 (in decimal degrees)

 Longitude: -97.30452 (in decimal degrees)

 Elevation: 1345

 Horizontal Datum: ☒ WGS84, ☐ NAD83, ☐ NAD27

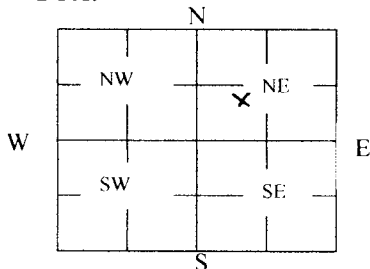
Collection Method:

2 WATER WELL OWNER: Phillips 66 South Terminal
RR#, St. Address, Box #: 2400 East 37th Street North
City, State ZIP Code: Wichita, KS 67219

☐ GPS unit (Make/Model: _____)

☐ Digital Map/Photo, ☒ Topographic Map, ☐ Land Survey

 Est. Accuracy: ☒ < 3 m, ☐ 3-5 m, ☐ 5-15 m, ☐ > 15 m

3 MARK WELL'S LOCATION WITH AN "X" IN SECTION BOX:

4 DEPTH OF WELL 8.08 ft.

 WELL'S STATIC WATER LEVEL 25.58 ft

WELL WAS USED AS:

☐ Domestic
☐ Irrigation
☐ Feedlot
☐ Industrial

☐ Public Water Supply
☐ Oil Field Water Supply
☐ Domestic (Lawn & Garden)
☐ Air Conditioning

☒ Dewatering
☐ Monitoring
☐ Injection Well
☐ Other MW-25

 Was a chemical/bacteriological sample submitted to Department? Yes ☐ No ☒
5 TYPE OF BLANK CASING USED:
☐ Steel
☒ PVC

☐ RMP (SR)
☐ ABS

☐ Wrought
☐ Asbestos-Cement

☐ Fiberglass
☐ Concrete Tile

☐ Other (Specify below) _____

 Blank casing diameter 2 in. Was casing pulled? Yes ☒ No ☐ If yes, how much 3-feet below grade

 Casing height above or below land surface 30 in.

6 GROUT PLUG MATERIAL:


Neat cement



Cement grout



Bentonite



Other _____

 Grout Plug Intervals: From 3 ft. to 25.58 ft., From N/A ft. to N/A ft., From N/A ft. to N/A ft.

What is the nearest source of possible contamination:

☐ Septic tank
☐ Sewer lines
☐ Watertight sewer lines
☐ Lateral lines
☐ Cess pool

☐ Seepage pit
☐ Pit privy
☐ Sewage lagoon
☐ Feedyard
☐ Livestock pens

☒ Fuel storage
☐ Fertilizer storage
☐ Insecticide storage
☐ Abandoned water well
☐ Oil well/Gas well

☐ Other (specify below) _____

 Direction from well? South

 How many feet? 285

FROM	TO	PLUGGING MATERIALS	FROM	TO	PLUGGING MATERIALS
0	3	Topsoil			
3	25.58	Bentonite (hydrated)			

7 CONTRACTOR'S OR LANDOWNER'S CERTIFICATION: This water well was plugged under my jurisdiction and was completed on (mo/day/year) 12-11-2018 and this record is true to the best of my knowledge and belief. Kansas Water Well Contractor's License No. 759. This Water Well Record was completed on (mo/day/year) 1-11-2019 under the business name of RAZEK Environmental, LLC by (signature) [Signature]

Send one white copy to Kansas Department of Health & Environment, Geology Section, 1000 SW Jackson Street, Ste. 420, Topeka, KS 66612-1367. Send one copy to WATER WELL OWNER and retain one for your records.

Visit us at <http://www.kdheks.gov/waterwell/index.html> Telephone 785-296-5524.

KSA82a-1212

Revised 1/20/2015