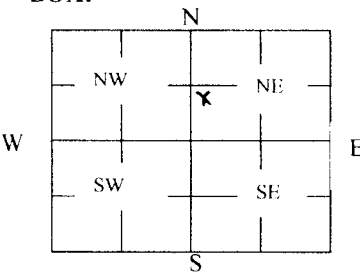


## WATER WELL PLUGGING RECORD Form WWC-5P

KSA 82a-1212

ID NO.

MW 45

<b>1 LOCATION OF WATER WELL:</b> County: <b>Sedgewick</b> Street/Rural Address of Well Location: if unknown, distance & direction from nearest town or intersection: If at owner's address, check here <input type="checkbox"/> Phillips 66 420 S. Keeler (1708-02) Bartlesville, OK 74004	Fraction <u>1/4 NW 1/4 SW 1/4 NE 1/4</u> Section Number <u>27</u> Township Number <u>T 26 S</u> Range Number <u>1</u> <input checked="" type="checkbox"/> E <input type="checkbox"/> W	<b>Global Positioning Systems (GPS) information:</b> Latitude: <u>37.76328</u> (in decimal degrees) Longitude: <u>-97.30785</u> (in decimal degrees) Elevation: <u>1346</u> Horizontal Datum: <input checked="" type="checkbox"/> WGS84, <input type="checkbox"/> NAD83, <input type="checkbox"/> NAD27 Collection Method: <input type="checkbox"/> GPS unit (Make/Model: _____) <input type="checkbox"/> Digital Map/Photo, <input checked="" type="checkbox"/> Topographic Map, <input type="checkbox"/> Land Survey Est. Accuracy: <input checked="" type="checkbox"/> < 3 m, <input type="checkbox"/> 3-5 m, <input type="checkbox"/> 5-15 m, <input type="checkbox"/> > 15 m	
<b>2 WATER WELL OWNER:</b> Phillips 66 South Terminal RR#, St. Address, Box #: <u>2400 East 37th Street North</u> City, State ZIP Code: <u>Wichita, KS 67219</u>	<b>3 MARK WELL'S LOCATION WITH AN "X" IN SECTION BOX:</b> <div style="text-align: center;">  </div>	
<b>4 DEPTH OF WELL</b> <u>7.54</u> ft. WELL'S STATIC WATER LEVEL <u>26.73</u> ft. WELL WAS USED AS: <div style="display: flex; justify-content: space-between;"> <div> <input type="checkbox"/> Domestic  <input type="checkbox"/> Irrigation  <input type="checkbox"/> Feedlot  <input type="checkbox"/> Industrial         </div> <div> <input type="checkbox"/> Public Water Supply  <input type="checkbox"/> Oil Field Water Supply  <input type="checkbox"/> Domestic (Lawn &amp; Garden)  <input type="checkbox"/> Air Conditioning         </div> <div> <input checked="" type="checkbox"/> Dewatering  <input type="checkbox"/> Monitoring  <input type="checkbox"/> Injection Well  <input type="checkbox"/> Other <u>MW-45</u> </div> </div> Was a chemical/bacteriological sample submitted to Department? Yes <input type="checkbox"/> No <input checked="" type="checkbox"/>	
<b>5 TYPE OF BLANK CASING USED:</b> <div style="display: flex; justify-content: space-between;"> <div> <input type="checkbox"/> Steel  <input checked="" type="checkbox"/> PVC         </div> <div> <input type="checkbox"/> RMP (SR)  <input type="checkbox"/> ABS         </div> <div> <input type="checkbox"/> Wrought  <input type="checkbox"/> Asbestos-Cement         </div> <div> <input type="checkbox"/> Fiberglass  <input type="checkbox"/> Concrete Tile         </div> <div> <input type="checkbox"/> Other (Specify below) _____         </div> </div> Blank casing diameter <u>2</u> in. Was casing pulled? Yes <input checked="" type="checkbox"/> No <input type="checkbox"/> If yes, how much <u>3-feet below grade</u> Casing height above or below land surface <u>30</u> in.	
<b>6 GROUT PLUG MATERIAL:</b> <input type="checkbox"/> Neat cement <input type="checkbox"/> Cement grout <input checked="" type="checkbox"/> Bentonite <input type="checkbox"/> Other _____ Grout Plug Intervals: From <u>3</u> ft. to <u>26.73</u> ft., From <u>N/A</u> ft. to <u>N/A</u> ft., From <u>N/A</u> ft. to <u>N/A</u> ft. What is the nearest source of possible contamination: <div style="display: flex; justify-content: space-between;"> <div> <input type="checkbox"/> Septic tank  <input type="checkbox"/> Sewer lines  <input type="checkbox"/> Watertight sewer lines  <input type="checkbox"/> Lateral lines  <input type="checkbox"/> Cess pool         </div> <div> <input type="checkbox"/> Seepage pit  <input type="checkbox"/> Pit privy  <input type="checkbox"/> Sewage lagoon  <input type="checkbox"/> Feedyard  <input type="checkbox"/> Livestock pens         </div> <div> <input checked="" type="checkbox"/> Fuel storage  <input type="checkbox"/> Fertilizer storage  <input type="checkbox"/> Insecticide storage  <input type="checkbox"/> Abandoned water well  <input type="checkbox"/> Oil well/Gas well         </div> <div> <input type="checkbox"/> Other (specify below) _____          Direction from well? <u>Southeast</u>          How many feet? <u>925</u> </div> </div> <table border="1" style="width:100%; border-collapse: collapse; margin-top: 10px;"> <thead> <tr> <th>FROM</th> <th>TO</th> <th>PLUGGING MATERIALS</th> <th>FROM</th> <th>TO</th> <th>PLUGGING MATERIALS</th> </tr> </thead> <tbody> <tr> <td>0</td> <td>3</td> <td>Topsoil</td> <td></td> <td></td> <td></td> </tr> <tr> <td>3</td> <td>26.73</td> <td>Bentonite (hydrated)</td> <td></td> <td></td> <td></td> </tr> <tr><td> </td><td> </td><td> </td><td> </td><td> </td><td> </td></tr> <tr><td> </td><td> </td><td> </td><td> </td><td> </td><td> </td></tr> <tr><td> </td><td> </td><td> </td><td> </td><td> </td><td> </td></tr> <tr><td> </td><td> </td><td> </td><td> </td><td> </td><td> </td></tr> <tr><td> </td><td> </td><td> </td><td> </td><td> </td><td> </td></tr> </tbody> </table>			FROM	TO	PLUGGING MATERIALS	FROM	TO	PLUGGING MATERIALS	0	3	Topsoil				3	26.73	Bentonite (hydrated)																																	
FROM	TO	PLUGGING MATERIALS	FROM	TO	PLUGGING MATERIALS	
0	3	Topsoil	
3	26.73	Bentonite (hydrated)	
<b>7 CONTRACTOR'S OR LANDOWNER'S CERTIFICATION:</b> This water well was plugged under my jurisdiction and was completed on (mo/day/year) <u>12-12-2018</u> and this record is true to the best of my knowledge and belief. Kansas Water Well Contractor's License No. <u>759</u> . This Water Well Record was completed on (mo/day/year) <u>1-11-2019</u> under the business name of <u>RAZEK Environmental, LLC</u> by (signature) <u>[Signature]</u>	

Send one white copy to Kansas Department of Health & Environment, Geology Section, 1000 SW Jackson Street, Ste. 420, Topeka, KS 66612-1367. Send one copy to WATER WELL OWNER and retain one for your records.  
 Visit us at <http://www.kdheks.gov/waterwell/index.html> Telephone 785-296-5524.