

**WATER WELL PLUGGING RECORD Form WWC-5P**

KSA 82a-1212

ID NO.

MW 21R

<b>1 LOCATION OF WATER WELL:</b> County: <u>Sedgewick</u>	Fraction <u>1/4 SW 1/4 SW 1/4 NE 1/4</u>	Section Number <u>27</u>	Township Number <u>T 26 S</u>	Range Number <u>1</u> <input checked="" type="checkbox"/> E <input type="checkbox"/> W
--	--	--------------------------	-------------------------------	--

 Street/Rural Address of Well Location: if unknown, distance & direction from nearest town or intersection: If at owner's address, check here ☐

☐ Phillips 66  
 420 S. Keeler (1708-02)  
 Bartlesville, OK 74004

**Global Positioning Systems (GPS) information:**

 Latitude: 37.76024 (in decimal degrees)

 Longitude: -97.30565 (in decimal degrees)

 Elevation: 1343

 Horizontal Datum: ☒ WGS84, ☐ NAD83, ☐ NAD27

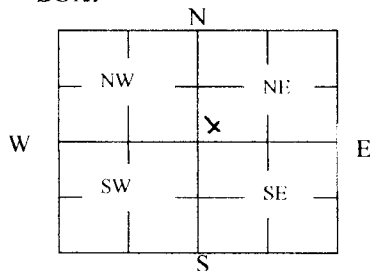
Collection Method:

☐ GPS unit (Make/Model: \_\_\_\_\_)

☐ Digital Map/Photo, ☒ Topographic Map, ☐ Land Survey

 Est. Accuracy: ☒ < 3 m, ☐ 3-5 m, ☐ 5-15 m, ☐ > 15 m

**2 WATER WELL OWNER:** Phillips 66 South Terminal  
 RR#, St. Address, Box #: 2400 East 37th Street North  
 City, State ZIP Code: Wichita, KS 67219

**3 MARK WELL'S LOCATION WITH AN "X" IN SECTION BOX:**

**4 DEPTH OF WELL** 6.85 ft.

 WELL'S STATIC WATER LEVEL 24.91 ft.

WELL WAS USED AS:

☐ Domestic  
☐ Irrigation  
☐ Feedlot  
☐ Industrial

☐ Public Water Supply  
☐ Oil Field Water Supply  
☐ Domestic (Lawn & Garden)  
☐ Air Conditioning

☒ Dewatering  
☐ Monitoring  
☐ Injection Well  
 Other MW-21R

 Was a chemical/bacteriological sample submitted to Department? Yes ☐ No ☒
**5 TYPE OF BLANK CASING USED:**
☐ Steel  
☒ PVC

☐ RMP (SR)  
☐ ABS

☐ Wrought  
☐ Asbestos-Cement

☐ Fiberglass  
☐ Concrete Tile

☐ Other (Specify below) \_\_\_\_\_

 Blank casing diameter 2 in. Was casing pulled? Yes ☒ No ☐ If yes, how much 3-feet below grade

 Casing height above or below land surface 30 in.

**6 GROUT PLUG MATERIAL:**
☐ Neat cement

☐ Cement grout

☒ Bentonite

☐ Other \_\_\_\_\_

 Grout Plug Intervals: From 3 ft. to 24.91 ft., From N/A ft. to N/A ft., From N/A ft. to N/A ft.

What is the nearest source of possible contamination:

☐ Septic tank  
☐ Sewer lines  
☐ Watertight sewer lines  
☐ Lateral lines  
☐ Cess pool

☐ Seepage pit  
☐ Pit privy  
☐ Sewage lagoon  
☐ Feedyard  
☐ Livestock pens

☒ Fuel storage  
☐ Fertilizer storage  
☐ Insecticide storage  
☐ Abandoned water well  
☐ Oil well/Gas well

☐ Other (specify below) \_\_\_\_\_

 Direction from well? East

 How many feet? 50

FROM	TO	PLUGGING MATERIALS	FROM	TO	PLUGGING MATERIALS
0	3	Topsoil			
3	24.91	Bentonite (hydrated)			

**7 CONTRACTOR'S OR LANDOWNER'S CERTIFICATION:** This water well was plugged under my jurisdiction and was completed on (mo/day/year) 12-11-2018 and this record is true to the best of my knowledge and belief. Kansas Water Well Contractor's License No. 759. This Water Well Record was completed on (mo/day/year) 1-11-2019 under the business name of RAZEK Environmental, LLC by (signature) [Signature]

Send one white copy to Kansas Department of Health & Environment, Geology Section, 1000 SW Jackson Street, Ste. 420, Topeka, KS 66612-1367. Send one copy to WATER WELL OWNER and retain one for your records.

Visit us at <http://www.kdheks.gov/waterwell/index.html> Telephone 785-296-5524.

KSA82a-1212

Revised 1/20/2015