WATER WELL PLUGGING RECORD Form WWC-5P KSA 82a-1212 ID NO. MW 19

1 LOCATION OF WATER WELL: County: Sedgewick | Fraction: ¼ SW ¼ NW ¼ SE ¼ | Section Number: 27 | Township Number: T 26 S | Range Number: 1 ☑ E ☐ W

Street/Rural Address of Well Location; if unknown, distance & direction from nearest town or intersection: If at owner's address, check here ☐
Phillips 66
420 S. Keeler (1708-02)
Bartlesville, OK 74004

Global Positioning Systems (GPS) information:
Latitude: 37.75608 (in decimal degrees)
Longitude: -97.30719 (in decimal degrees)
Elevation: 1343
Horizontal Datum: ☑ WGS84, ☐ NAD83, ☐ NAD27
Collection Method:
☐ GPS unit (Make/Model: ____)
☐ Digital Map/Photo, ☑ Topographic Map, ☐ Land Survey
Est. Accuracy: ☑ < 3 m, ☐ 3-5 m, ☐ 5-15 m, ☐ > 15 m

2 WATER WELL OWNER: Phillips 66 South Terminal
RR#, St. Address, Box #: 2400 East 37th Street North
City, State ZIP Code: Wichita, KS 67219

3 MARK WELL'S LOCATION WITH AN "X" IN SECTION BOX:

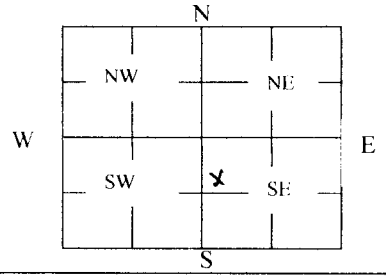

4 DEPTH OF WELL 12.33 ft.
WELL'S STATIC WATER LEVEL 25.00 ft
WELL WAS USED AS:

☐ Domestic	☐ Public Water Supply	☐ Dewatering
☐ Irrigation	☐ Oil Field Water Supply	☑ Monitoring
☐ Feedlot	☐ Domestic (Lawn & Garden)	☐ Injection Well
☐ Industrial	☐ Air Conditioning	☐ Other MW-19

Was a chemical/bacteriological sample submitted to Department? Yes ☐ No ☑

5 TYPE OF BLANK CASING USED:

☐ Steel	☐ RMP (SR)	☐ Wrought	☐ Fiberglass	☐ Other (Specify below)
☑ PVC	☐ ABS	☐ Asbestos-Cement	☐ Concrete Tile	

Blank casing diameter 2 in. Was casing pulled? Yes ☑ No ☐ If yes, how much 3-feet below grade
Casing height above or below land surface 30 in.

6 GROUT PLUG MATERIAL: ☐ Neat cement ☐ Cement grout ☑ Bentonite ☐ Other ____

Grout Plug Intervals: From 3 ft. to 25.00 ft., From N/A ft. to N/A ft., From N/A ft. to N/A ft.

What is the nearest source of possible contamination:

☐ Septic tank	☐ Seepage pit	☑ Fuel storage	☐ Other (specify below)
☐ Sewer lines	☐ Pit privy	☐ Fertilizer storage	
☐ Watertight sewer lines	☐ Sewage lagoon	☐ Insecticide storage	
☐ Lateral lines	☐ Feedyard	☐ Abandoned water well	Direction from well? Southeast
☐ Cess pool	☐ Livestock pens	☐ Oil well/Gas well	How many feet? 350

FROM	TO	PLUGGING MATERIALS	FROM	TO	PLUGGING MATERIALS
0	3	Topsoil			
3	25.00	Bentonite (hydrated)			

7 CONTRACTOR'S OR LANDOWNER'S CERTIFICATION: This water well was plugged under my jurisdiction and was completed on (mo/day/year) 12-11-2018 and this record is true to the best of my knowledge and belief. Kansas Water Well Contractor's License No. 759. This Water Well Record was completed on (mo/day/year) 1-11-2019 under the business name of RAZEK Environmental, LLC by (signature) [signature]

Send one white copy to Kansas Department of Health & Environment, Geology Section, 1000 SW Jackson Street, Ste. 420, Topeka, KS 66612-1367. Send one copy to WATER WELL OWNER and retain one for your records.
Visit us at http://www.kdheks.gov/waterwell/index.html Telephone 785-296-5524.