


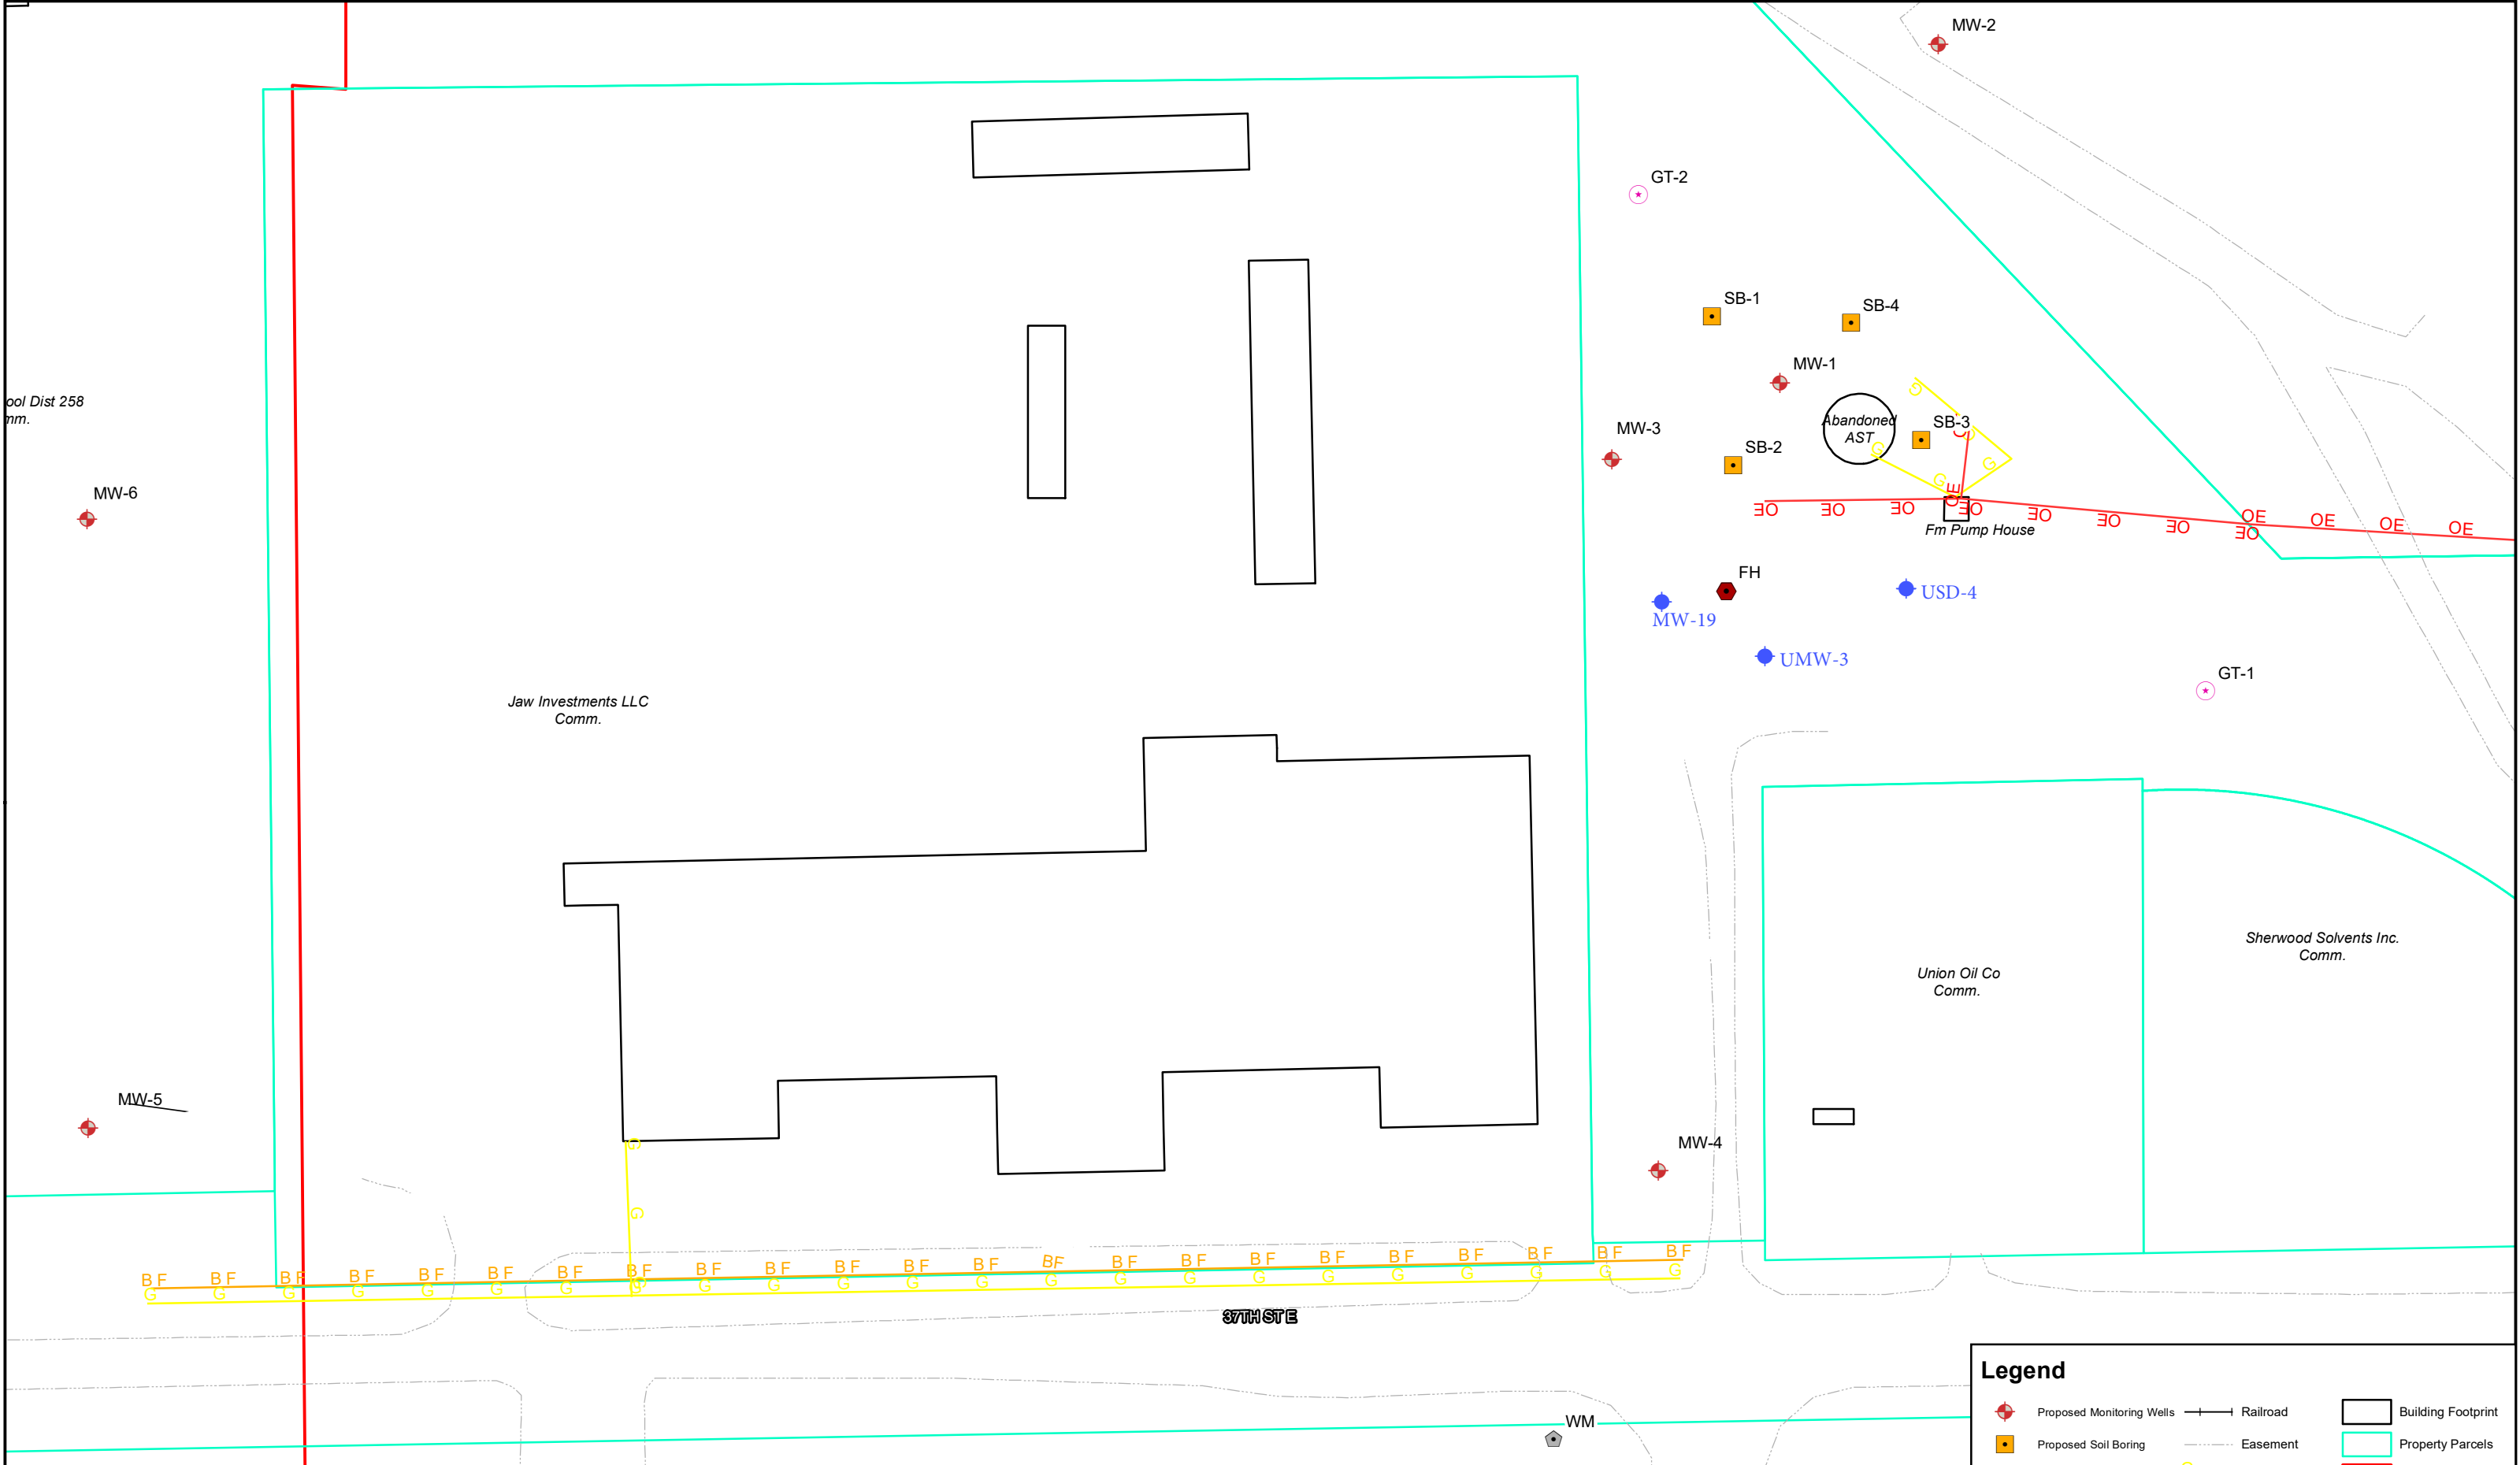









**WATER WELL RECORD      Form WWC-5**☐ Original Record    ☐ Correction    ☐ Change in Well Use

Division of Water  
Resources App. No.

Well ID

[illegible]



	FIGURE: <b>2.0</b>	FIGURE NAME: <b>Site Base Map</b>	<b>Wichita Public Schools</b> <b>3850 N. Hydraulic</b> <b>Wichita, KS</b> <b>KDHE#: A2-087-40497</b>	<div>Feet</div> <div>080</div> <div><div></div></div> <div>1 in = 80 feet</div> <div></div>	 Fire Hydrant	 Gas	 Site Boundary
	DATE: <b>07/29/20</b>	PROJECT NUMBER: <b>2074056</b>			 Proposed Geotech	 Buried Fiber	
	DRAWN BY: <b>CN</b>	PROJECT MANAGER: <b>A.Chadd</b>			 Water Meter	 Overhead Electric	
 Existing Monitoring Wells							
ALL BOUNDARIES AND LOCATIONS ARE APPROXIMATE							