


WATER WELL RECORD Form WWC-5









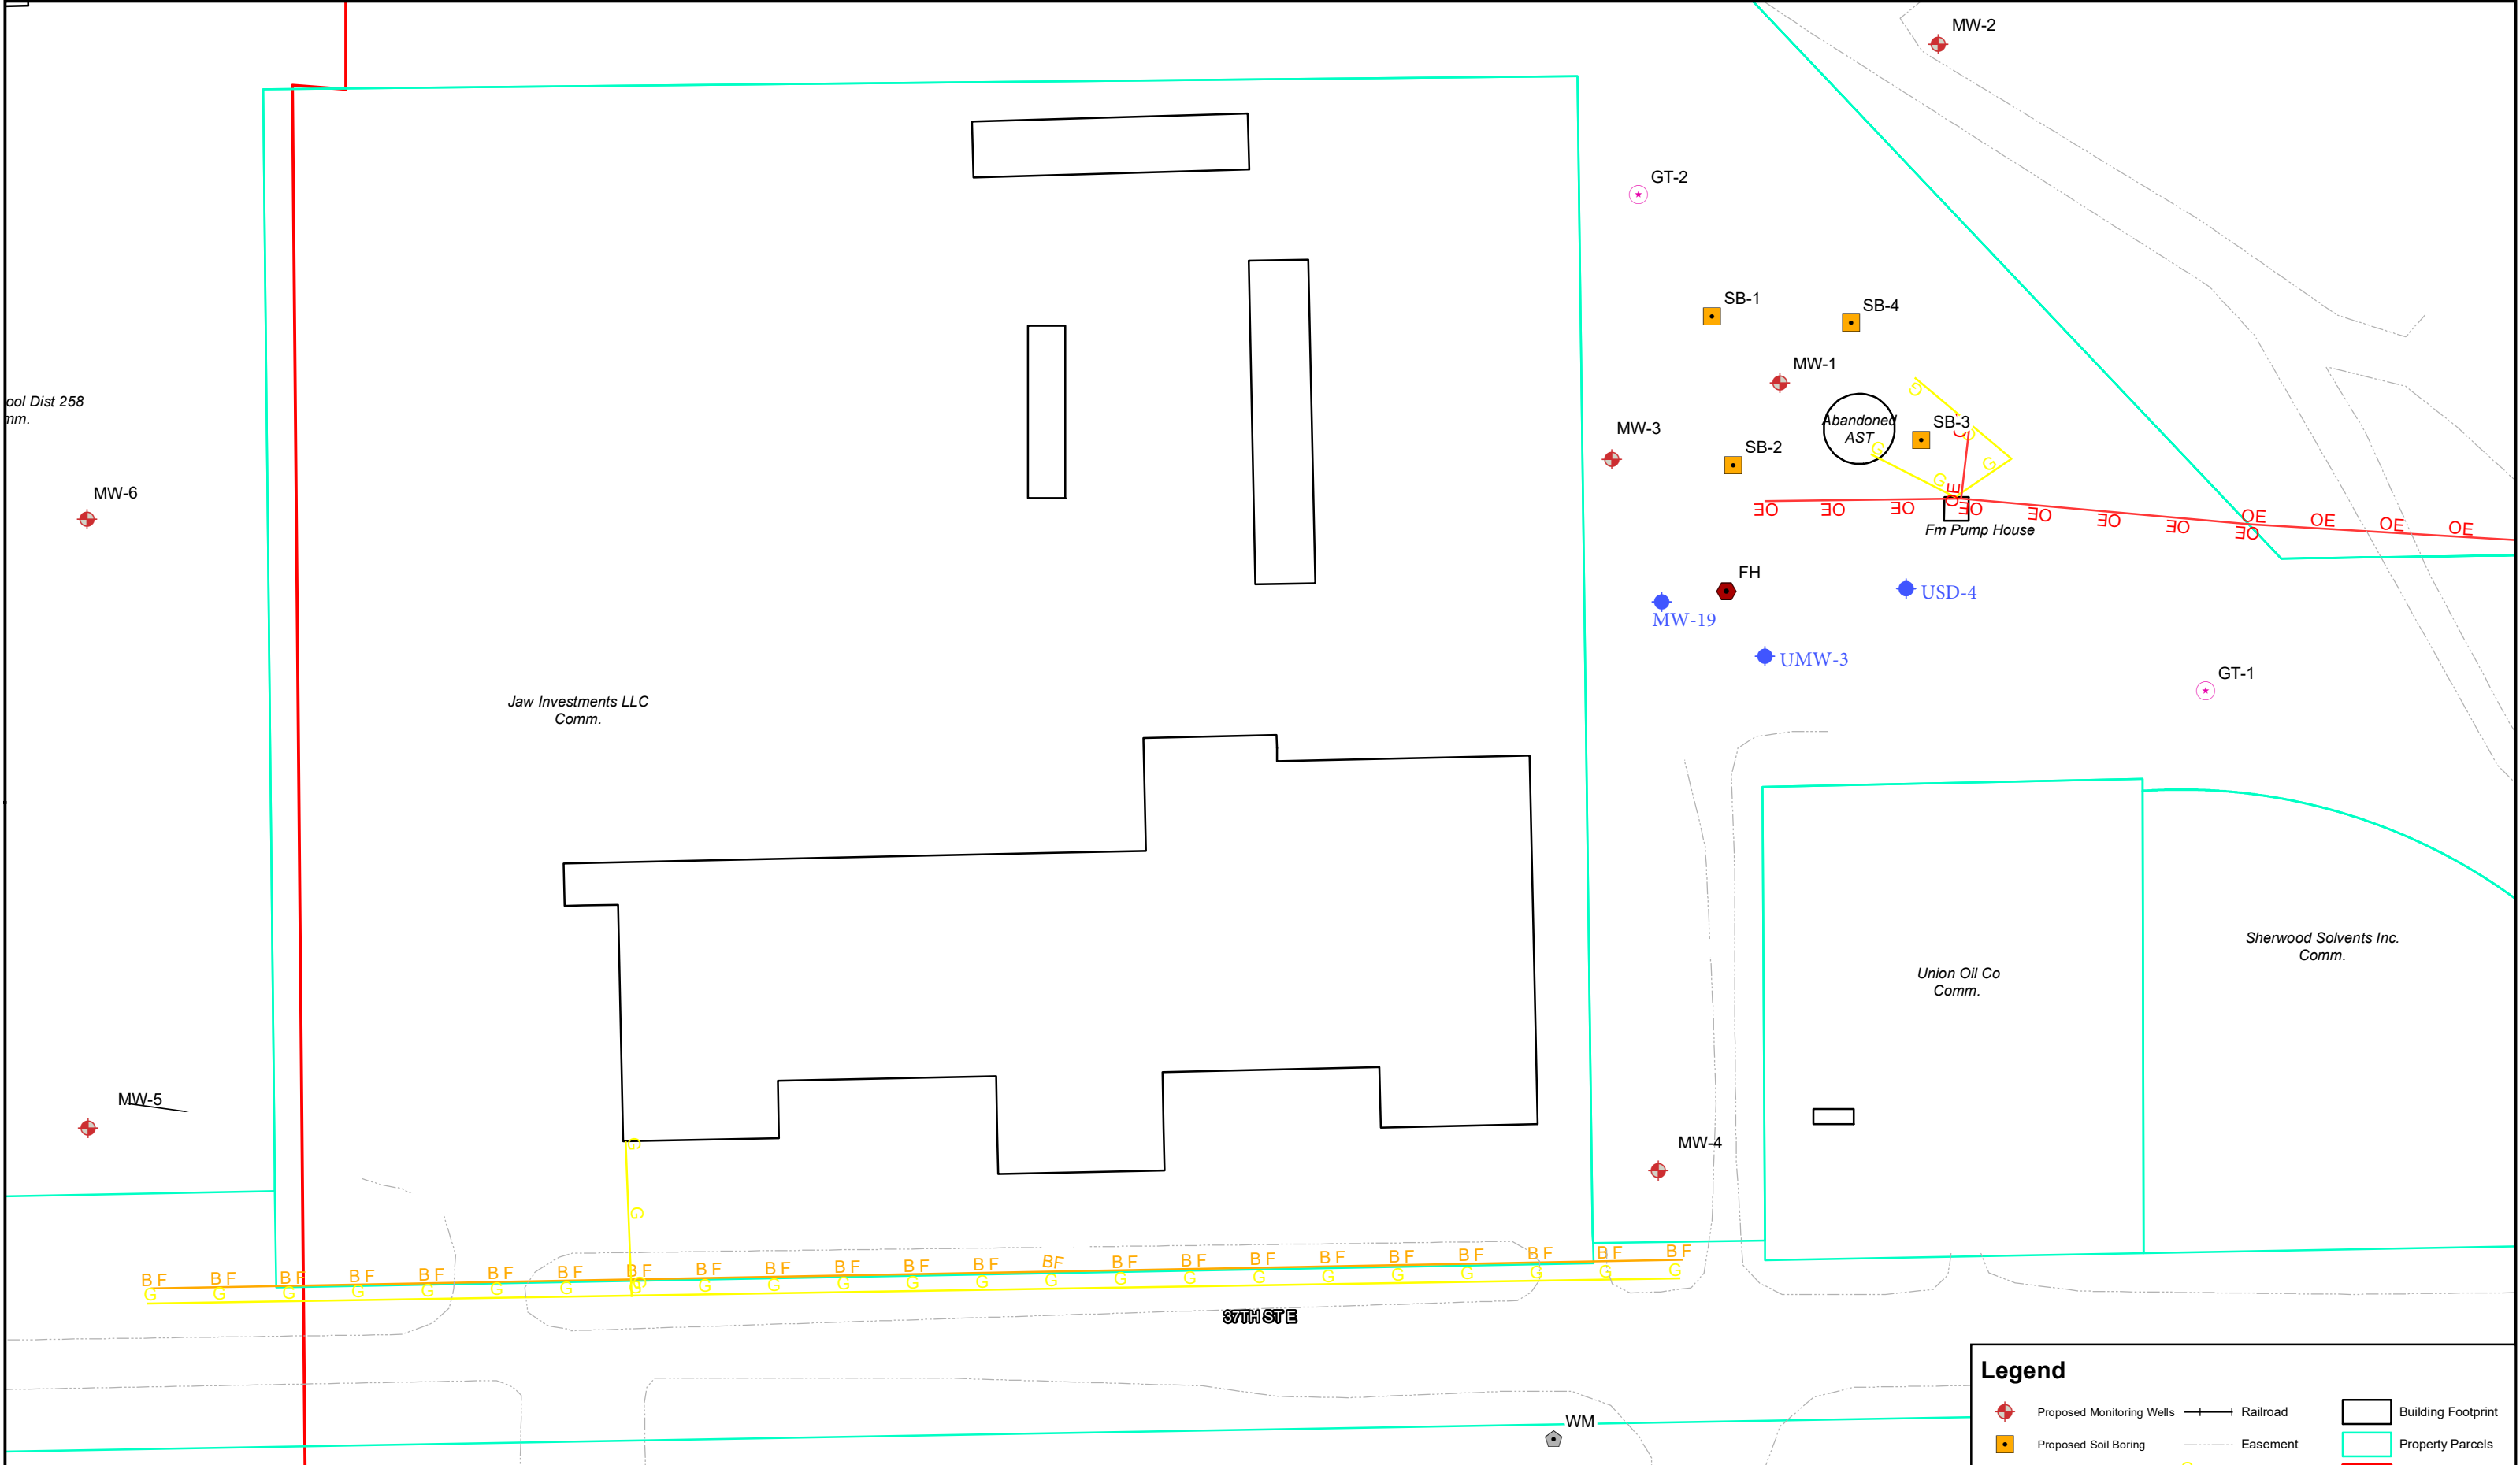

☐ Original Record ☐ Correction ☐ Change in Well Use

Division of Water
Resources App. No.

Well ID

[illegible]



	FIGURE: 2.0	FIGURE NAME: Site Base Map	Wichita Public Schools 3850 N. Hydraulic Wichita, KS KDHE#: A2-087-40497	<div>Feet</div> <div>080</div> <div><div></div></div> <div>1 in = 80 feet</div> <div></div>	<div><div> Fire Hydrant</div><div> Proposed Geotech</div><div> Water Meter</div><div> Existing Monitoring Wells</div><div> Gas</div><div> Buried Fiber</div><div> Overhead Electric</div><div> Site Boundary</div></div> <div>ALL BOUNDARIES AND LOCATIONS ARE APPROXIMATE</div>
	DATE: 07/29/20	PROJECT NUMBER: 2074056			
	DRAWN BY: CN	PROJECT MANAGER: A.Chadd			