
WATER WELL PLUGGING R	ECORD	Form WW	C-5P	KSA 82	a-1212 ID NO.	MW-10	
1 LOCATION OF WATER WELL:	Fraction		Section	Number	Township Number		
		1/4 SW 1/4 SW 1/2		eitioning	T 26 S	1 DE W	
Street/Rural Address of Well Location; if unknown, distance & direction from nearest town or intersection: If at owner's address,				Global Positioning Systems (GPS) information: Latitude: 37.81236 (in decimal degrees)			
check here Phillips 66 Valley Center Pipeline				Latitude: 37.81236 (in decimal degrees) Longitude: -97.36917 (in decimal degrees)			
7100 North Clarence Avenue Valley Center, KS 67147				Elevation: 1346 Horizontal Datum: WGS84, NAD83, NAD27			
Valley Certer, NO 07 147				Collection Method:			
2 WATER WELL OWNER: Phillips 66				S unit (Mak	re/Model:		
RR#, St. Address, Box #: 420 South Keeler (1708-02) City, State ZIP Code: Bartlesville, OK 74004				Digital Map/Photo, Topographic Map, Land Survey			
Salliesville, OK 74004				Est. Accuracy: $2 < 3 \text{ m}$, $3 - 5 \text{ m}$, $5 - 15 \text{ m}$, $> 15 \text{ m}$			
3 MARK WELL'S LOCATION 4 DEPTH OF WELL 25 ft.							
WITH AN "X" IN SECTION BOX: N WELL'S STATIC WAT WELL WAS USED AS:				TER LEVEL 16.94 ft			
				- · · · · · · · · · · · · · · · · · · ·			
NW NE Domestic Public Water Supply Dewatering							
Irrigation Oil Field Water Supply Monitoring							
W Domestic (Lawn & Garden) Injection Well							
SW SE Industrial Li Air Conditioning Li Other MW-10							
Was a chemical/bacteriological sample submitted to Department? Yes No							
5 TYPE OF BLANK CASING USED:							
Steel RMP (SR) Wrought Fiberglass Other (Specify below) ABS Concrete Tile							
Blank casing diameter 2 in. Was casing pulled? Yes No If yes, how much 3-feet below grade Casing height above or below land surface 0 in.							
6 GROUT PLUG MATERIAL: Neat cement Cement grout Bentonite Other							
Grout Plug Intervals: From 3 ft. to 25 ft., From N/A ft. to N/A ft., From N/A ft. to N/A ft.							
Growt rug intervals. From 6 It. to 20 It., From 1077 It. to 1077 It. to 1077 It. to 1077 It.							
What is the nearest source of possible contamination:							
Septic tank Seepage pit Fuel storage Other (specify below) Sewer lines Pit privy Fertilizer storage Petroleum Pipeline							
Watertight sewer lines Sewage lagoon Insecticide storage							
Lateral lines Feedyard Abandoned water well Direction from well? Southwest Cess pool Livestock pens Oil well/Gas well How many feet? 138							
Cess pool Livestock pens Oil well/Gas well How many feet? 138							
	GING MATE	ERIALS	FROM	TO	PLUGGING	MATERIALS	
0 3 Topsoil							
3 25.0 Bentonite (h	ydrated)						
							
							
			•				
7 CONTRACTOR'S OR LANDOWNER'S CERTIFICATION: This water well was plugged under my jurisdiction and was							
completed on (mo/day/year) 10/28/2021 and this record is true to the best of my knowledge and belief. Kansas Water Well Contractor's License No. 759 . This Water Well Record was completed (m) (mb/day/year) 12/26/2021 under the							
business name of RAZEK Environmental, LLC by (signature)							
Send one white copy to Kansas Department of Health & Environment, Geology Section, 1000 SW Jackson Street, Ste. 420, Topeka, KS 66612-1367. Send one copy to WATER WELL OWNER and retain one for your records.							
Visit us at http://www.kdheks.gov/waterwell/index.html Telephone 785-296-5524.							
KSA82a-1212 Revised 1/20/2015							

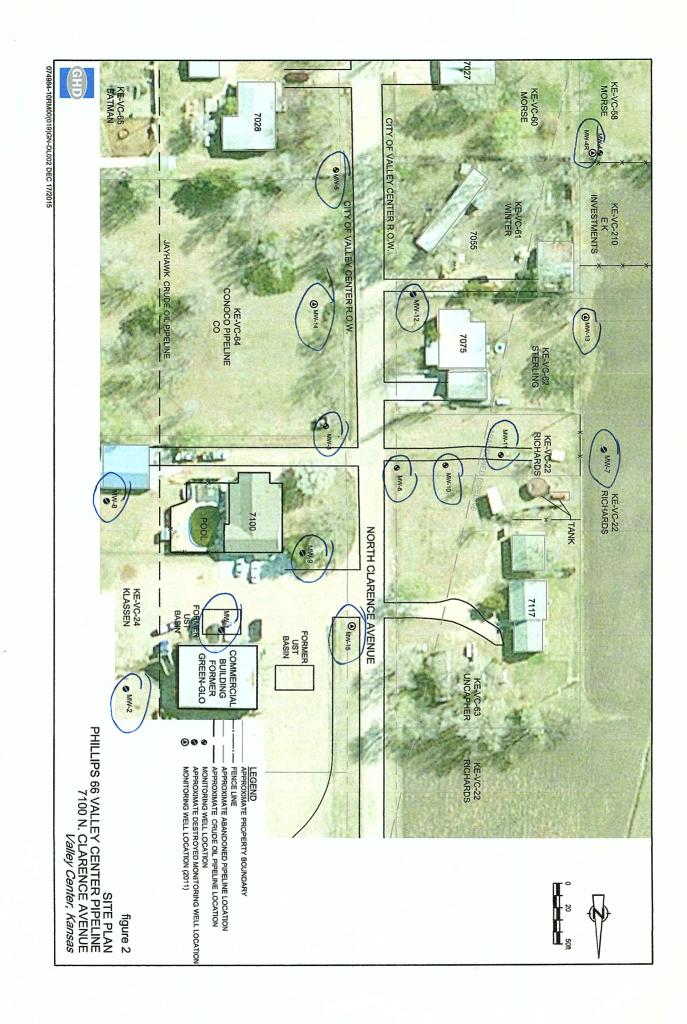

* 1 7