
WATER WELL PLUGGING RECO	ORD Form WW	C-5P KSA 82	a-1212 ID NO.	MW-13
1 LOCATION OF WATER WELL: Fract	ion	Section Number	Township Number	Range Number
	14 SE 14 SW 14 SW 1		T '26 S	1 V E
Street/Rural Address of Well Location; if unknown, distance & direction from nearest town or intersection: If at owner's address, Global Positioning Systems (GPS) information: Latitude: 37.81208 (in decimal degrees)				
check here Phillips 66 Valley Center	Longitude: <u>-97.36954</u> (in decimal degrees)			
7100 North Clarence Avenue		Elevation: 1346 Horizontal Datum: WGS84, NAD83, NAD27		
Valley Center, KS 67147		Horizontal Datum: WGS84, NAD83, NAD27 Collection Method:		
2 WATER WELL OWNER: Phillips 66	e/Model:			
RR#, St. Address, Box #: 420 South Keeler (1708-02)		Digital Map/Photo, Topographic Map, Land Survey		
City, State ZIP Code: `Bartlesville, OK 74004		Est. Accuracy: ☑ <3 m, □ 3-5 m, □ 5-15 m, □ > 15 m		
3 MARK WELL'S LOCATION 4 DEPTH OF WELL 25 ft.				
WITH AN "X" IN SECTION				
BOX: WELL'S STATIC WATER LEVEL 16.24 ft				
WELL WAS USED AS:				
NW NE Domestic Public Water Supply Dewatering				
W Irrigation Oil Field Water Supply Monitoring Domestic (Lawn & Garden) Injection Well				
Industrial Air Conditioning Other MW-13				
Was a chemical/bacteriological sample submitted to Department? Yes No				
5 TYPE OF BLANK CASING USED:				
Steel RMP (SR) Wrought Fiberglass Other (Specify below) PVC ABS Asbestos-Cement Concrete Tile				
Blank casing diameter 2 in. Was	casing pulled? Yes	No If yes, ho	w much 3-feet below	grade
Casing height above or below land surface 0 in.				
6 GROUT PLUG MATERIAL: Neat cement Cement grout Bentonite Other				
Grout Plug Intervals: From 3 ft. to 25 ft., From N/A ft. to N/A ft., From N/A ft. to N/A ft.				
What is the nearest source of possible contamination: Septic tank Seepage pit Fuel storage Other (specify below)				
Septic tank Seepage pit Fuel storage Other (specify below) Pit privy Fertilizer storage Petroleum Pipeline				
Watertight sewer lines Sewage lagoon Insecticide storage				
Lateral lines Feedyard Abandoned water well Direction from well? Southwest Cess pool Livestock pens Oil well/Gas well How many feet? 437				
	MATERIALS	FROM TO	PLUGGING	MATERIALS
0 3 Topsoil				
3 25.0 Bentonite (hydrate	ea)			

7 CONTRACTOR'S OR LANDOWNER'S CERTIFICATION: This water well was plugged under my jurisdiction and was				
completed on (mo/day/year) 10/28/2021 and this record is true to the best of my knowledge and belief. Kansas Water				
Well Contractor's License No. 759 . This Water Well Record was completed on (no/day/year) 12/26/2021 under the business name of RAZEK Environmental, LLC by (signature)				
of (organism) and				
Send one white copy to Kansas Department of Health & Environment, Geology Section, 1000 SW Jackson Street, Ste. 420, Topeka, KS				
66612-1367. Send one copy to WATER WELL OWNER and retain one for your records. Visit us at http://www.kdheks.gov/waterwell/index.html Telephone 785-296-5524.				
	KSA	82a-1212		Revised 1/20/2015

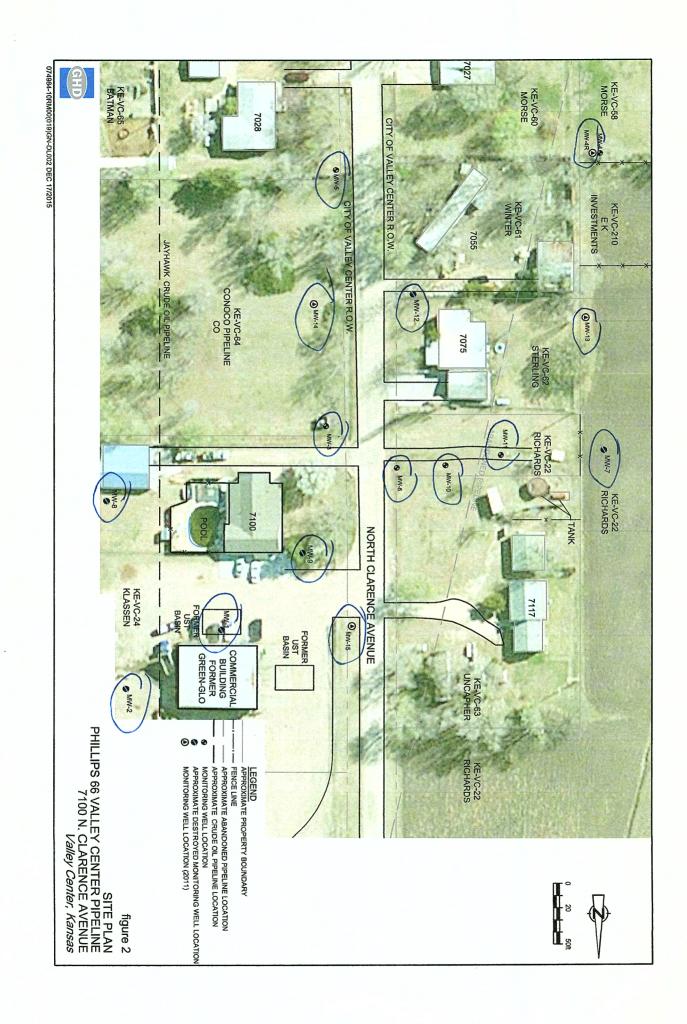

* 1 7