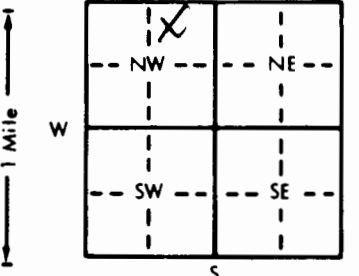


1 LOCATION OF WATER WELL: County: <u>Sedgwick</u> Fraction: <u>NN 1/4 NE 1/4 NN 1/4</u> Section Number: <u>2</u> Township Number: <u>T26</u> S Range Number: <u>R 1</u> EW	
Distance and direction from nearest town or city street address of well if located within city? <u>LOT 3</u>	
2 WATER WELL OWNER: <u>ESTON R ASH</u> RR#, St. Address, Box #: <u>542 N GOLBY AVE.</u> City, State, ZIP Code: <u>VALLEY CENTER KS 67147</u> Board of Agriculture, Division of Water Resources Application Number:	
3 LOCATE WELL'S LOCATION WITH AN "X" IN SECTION BOX: 	4 DEPTH OF COMPLETED WELL: <u>80</u> ft. ELEVATION: Depth(s) Groundwater Encountered 1. <u>65</u> ft. 2. ft. 3. ft. WELL'S STATIC WATER LEVEL <u>30</u> ft. below land surface measured on mo/day/yr <u>Oct 3 88</u> Pump test data: Well water was ft. after hours pumping gpm Est. Yield <u>20</u> gpm: Well water was ft. after hours pumping gpm Bore Hole Diameter: <u>10</u> in. to ft., and in. to ft. WELL WATER TO BE USED AS: <input checked="" type="checkbox"/> 1 Domestic <input type="checkbox"/> 3 Feedlot <input type="checkbox"/> 6 Oil field water supply <input type="checkbox"/> 9 Dewatering <input type="checkbox"/> 12 Other (Specify below) <input type="checkbox"/> 2 Irrigation <input type="checkbox"/> 4 Industrial <input type="checkbox"/> 7 Lawn and garden only <input type="checkbox"/> 10 Monitoring well Was a chemical/bacteriological sample submitted to Department? Yes <input type="checkbox"/> No <input checked="" type="checkbox"/> If yes, mo/day/yr sample was submitted Water Well Disinfected <input checked="" type="checkbox"/> Yes <input type="checkbox"/> No
5 TYPE OF BLANK CASING USED: 1 Steel <input type="checkbox"/> 3 RMP (SR) <input type="checkbox"/> 5 Wrought iron <input type="checkbox"/> 8 Concrete tile <input type="checkbox"/> CASING JOINTS: <input checked="" type="checkbox"/> Glued <input type="checkbox"/> Clamped 2 PVC <input type="checkbox"/> 4 ABS <input checked="" type="checkbox"/> 6 Asbestos-Cement <input type="checkbox"/> 9 Other (specify below) <input type="checkbox"/> Welded Blank casing diameter <u>5</u> in. to ft., Dia. in. to ft., Dia. in. to ft. Casing height above land surface <u>+12</u> in., weight <u>200</u> lbs./ft. Wall thickness or gauge No. TYPE OF SCREEN OR PERFORATION MATERIAL: 1 Steel <input type="checkbox"/> 3 Stainless steel <input type="checkbox"/> 5 Fiberglass <input type="checkbox"/> 8 RMP (SR) <input type="checkbox"/> 10 Asbestos-cement <input type="checkbox"/> 2 Brass <input type="checkbox"/> 4 Galvanized steel <input type="checkbox"/> 6 Concrete tile <input checked="" type="checkbox"/> 9 ABS <input type="checkbox"/> 11 Other (specify) <input type="checkbox"/> SCREEN OR PERFORATION OPENINGS ARE: 1 Continuous slot <input type="checkbox"/> 3 Mill slot <input type="checkbox"/> 5 Gauzed wrapped <input type="checkbox"/> 8 Saw cut <input checked="" type="checkbox"/> 11 None (open hole) 2 Louvered shutter <input type="checkbox"/> 4 Key punched <input type="checkbox"/> 6 Wire wrapped <input type="checkbox"/> 9 Drilled holes <input type="checkbox"/> 20 Other (specify) <input type="checkbox"/> SCREEN-PERFORATED INTERVALS: From <u>60</u> ft. to <u>80</u> ft., From ft. to ft. GRAVEL PACK INTERVALS: From <u>20</u> ft. to <u>80</u> ft., From ft. to ft. From ft. to ft., From ft. to ft.	
6 GROUT MATERIAL: <u>3</u> Neat cement <u>20</u> Cement grout <u>3</u> Bentonite <input type="checkbox"/> 4 Other Grout Intervals: From ft. to ft., From ft. to ft., From ft. to ft. What is the nearest source of possible contamination: 1 Septic tank <input type="checkbox"/> 4 Lateral lines <input type="checkbox"/> 7 Pit privy <input type="checkbox"/> 10 Livestock pens <input type="checkbox"/> 14 Abandoned water well <input type="checkbox"/> 2 Sewer lines <input type="checkbox"/> 5 Cess pool <input type="checkbox"/> 8 Sewage lagoon <input type="checkbox"/> 11 Fuel storage <input type="checkbox"/> 15 Oil well/Gas well <input type="checkbox"/> 3 Watertight sewer lines <input type="checkbox"/> 6 Seepage pit <input type="checkbox"/> 9 Feedyard <input type="checkbox"/> 12 Fertilizer storage <input type="checkbox"/> 16 Other (specify below) <u>not Dev.</u> 13 Insecticide storage <input type="checkbox"/> Direction from well? <u>DOWN SLOPE</u> How many feet? <u>+75</u> FROM TO LITHOLOGIC LOG FROM TO PLUGGING INTERVALS <u>0</u> <u>3</u> <u>dirt</u> <u>0</u> <u>3</u> <u>3</u> <u>7</u> <u>green shale</u> <u>3</u> <u>7</u> <u>7</u> <u>65</u> <u>yellow clay</u> <u>7</u> <u>65</u> <u>65</u> <u>80</u> <u>gray sandy lime</u> <u>65</u> <u>80</u>	
7 CONTRACTOR'S OR LANDOWNER'S CERTIFICATION: This water well was (1) constructed, (2) reconstructed, or (3) plugged under my jurisdiction and was completed on (mo/day/year) <u>Oct 3 88</u> and this record is true to the best of my knowledge and belief. Kansas Water Well Contractor's License No. <u>493</u> This Water Well Record was completed on (mo/day/yr) <u>Nov 28 88</u> under the business name of <u>Kaiser Well Drilling</u> by (signature) <u>Jerry Kaiser</u>	