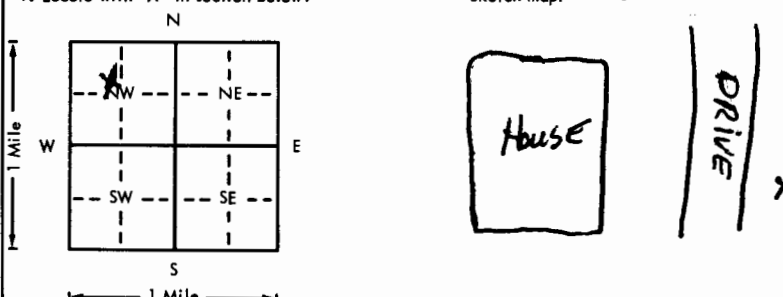


USE TYPEWRITER OR BALL  
POINT PEN-PRESS FIRMLY,  
PRINT CLEARLY.

WATER WELL RECORD  
KSA 82a-1201-1215

Kansas Department of Health and  
Environment-Division of Environment  
(Water well Contractors)  
Topeka, Kansas 66620

1. Location of well:		County <b>SEDGWICK</b>	Fraction <b>SW 1/4 NW 1/4 NW 1/4</b>	Section number <b>6</b>	Township number <b>T 26</b>	Range number <b>S R 1E</b>	E/W
2. Distance and direction from nearest town or city: Street address of well location if in city: <b>7610 N. MERIDIAN</b>				3. Owner of well: <b>RAYMONO BOTTS</b> R.R. or street: <b>7610 N. MERIDIAN</b> City, state, zip code: <b>VALLEY CENTER, KS.</b>			
4. Locate with "X" in section below:		Sketch map:		6. Bore hole dia. <b>11</b> in. Completion date <b>9-9-77</b> Well depth <b>40</b> ft.			
				7. <input checked="" type="checkbox"/> Cable tool <input checked="" type="checkbox"/> Rotary <input type="checkbox"/> Driven <input type="checkbox"/> Dug <input type="checkbox"/> Hollow rod <input type="checkbox"/> Jetted <input type="checkbox"/> Bored <input type="checkbox"/> Reverse rotary			
5. Type and color of material		From		To		8. Use: <input checked="" type="checkbox"/> Domestic <input type="checkbox"/> Public supply <input type="checkbox"/> Industry <input type="checkbox"/> Irrigation <input type="checkbox"/> Air conditioning <input type="checkbox"/> Stock <input type="checkbox"/> Lawn <input type="checkbox"/> Oil field water <input type="checkbox"/> Other	
<b>Topsoil</b>		<b>0</b>		<b>9</b>		9. Casing: Material <b>Steel</b> Height: Above or below Threaded <input type="checkbox"/> Welded <input checked="" type="checkbox"/> Surface <b>12</b> in. RMP <input type="checkbox"/> PVC <input type="checkbox"/> Weight <b>1.5</b> lbs./ft. Dia. <b>5</b> in. to <b>40</b> ft. depth Wall Thickness: inches or Dia. <input type="checkbox"/> in. to <input type="checkbox"/> ft. depth gage No. <b>200</b>	
<b>SAND - FINE</b>		<b>9</b>		<b>15</b>		10. Screen: Manufacturer's name <b>JAL</b> Type <b>100</b> Dia. <b>5"</b> Slot/gauze <b>.065</b> Length <b>10'</b> Set between <b>30</b> ft. and <b>40</b> ft. ft. and <input type="checkbox"/> ft. Gravel pack? <b>YES</b> Size range of material <b>5-30</b>	
<b>GRAVEL - COARSE</b>		<b>15</b>		<b>40</b>		11. Static water level: <b>18</b> ft. below land surface Date <b>9-9-77</b>	
						12. Pumping level below land surfaces: <b>19</b> ft. after <b>1</b> hrs. pumping <b>10</b> g.p.m. ft. after <input type="checkbox"/> hrs. pumping <input type="checkbox"/> g.p.m. Estimated maximum yield <b>60+</b> g.p.m.	
						13. Water sample submitted: <input type="checkbox"/> Yes <input checked="" type="checkbox"/> No Date <input type="checkbox"/>	
						14. Well head completion: <input checked="" type="checkbox"/> Pitless adapter <input type="checkbox"/> <input type="checkbox"/> Inches above grade	
						15. Well grouted? <b>YES</b> With: <b>Neat cement</b> <input type="checkbox"/> Bentonite <input type="checkbox"/> Concrete Depth: From <b>0</b> ft. to <b>10</b> ft.	
						16. Nearest source of possible contamination: ft. <b>100</b> Direction <b>E</b> Type <b>SEPTIC</b> Well disinfected upon completion? <input checked="" type="checkbox"/> Yes <input type="checkbox"/> No	
						17. Pump: Manufacturer's name <b>DUNSTON</b> Not installed Model number <b>DNS251</b> HP <b>1/2</b> Volts <b>110</b> Length of drop pipe <b>35</b> ft. capacity <input type="checkbox"/> g.p.m. Type: <input checked="" type="checkbox"/> Submersible <input type="checkbox"/> Turbine <input type="checkbox"/> Jet <input type="checkbox"/> Reciprocating <input type="checkbox"/> Centrifugal <input type="checkbox"/> Other	
18. Elevation:		19. Remarks:		20. Water well contractor's certification: This well was drilled under my jurisdiction and this report is true to the best of my knowledge and belief. <b>21st Electric</b> <b>129</b> Business name <b>512 W. 21st</b> License No. Address <b>J. Harris</b> Date <b>9-20-77</b> Signed <input type="checkbox"/> Authorized representative			
Topography: <input type="checkbox"/> Hill <input type="checkbox"/> Slope <input type="checkbox"/> Upland <input checked="" type="checkbox"/> Valley		Customer to be Concrete SMB - Signature on file					

Forward the white, blue and pink copies to the Department of Health and Environment

Form WWC-5