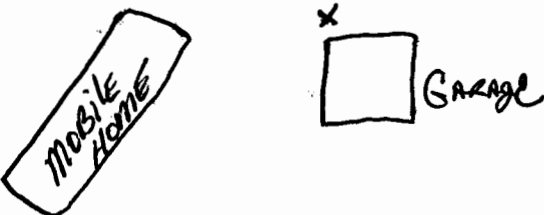


USE TYPEWRITER OR BALL
POINT PEN-PRESS FIRMLY,
PRINT CLEARLY.

WATER WELL RECORD
KSA 82a-1201-1215

Kansas Department of Health and
Environment-Division of Environment
(Water well Contractors)
Topeka, Kansas 66620

1. Location of well:		County SEDGWICK	Fraction SW 1/4 NW 1/4 NW 1/4	Section number 6	Township number T 26 S R 1E	Range number E/W
2. Distance and direction from nearest town or city: Street address of well location if in city:		7614 N. Meridian Valley Center, KS.		3. Owner of well: R.R. or street: City, state, zip code: L. DENNIS 7614 N. Meridian Valley Center, KS		
4. Locate with "X" in section below: N W E S 1 Mile 1 Mile		Sketch map: 		6. Bore hole dia. 11 in. Completion date 9-16-77 Well depth 40 ft.		
5. Type and color of material		From		To		7. Cable tool <input checked="" type="checkbox"/> Rotary <input type="checkbox"/> Driven <input type="checkbox"/> Dug <input type="checkbox"/> Hollow rod <input type="checkbox"/> Jetted <input type="checkbox"/> Bored <input type="checkbox"/> Reverse rotary
Topsoil		0		9		8. Use: <input checked="" type="checkbox"/> Domestic <input type="checkbox"/> Public supply <input type="checkbox"/> Industry <input type="checkbox"/> Irrigation <input type="checkbox"/> Air conditioning <input type="checkbox"/> Stock <input type="checkbox"/> Lawn <input type="checkbox"/> Oil field water <input type="checkbox"/> Other
Sand - fine		9		15		9. Casing: Material Steel Height: Above or below Threaded <input type="checkbox"/> Welded <input checked="" type="checkbox"/> Surface 12 in. RMP <input type="checkbox"/> PVC <input type="checkbox"/> Weight 1.5 lbs./ft. Dia. 5 in. to 40 ft. depth Wall Thickness: inches or Dia. <input type="checkbox"/> in. to <input type="checkbox"/> ft. depth gage No. 200
Gravel - coarse		15		40		10. Screen: Manufacturer's name J&L Type 100 Dia. 5" Slot/gauze .065 Length 10' Set between 30 ft. and 40 ft. ft. and <input type="checkbox"/> ft. Gravel pack? YES Size range of material 5-38
						11. Static water level: <input type="checkbox"/> mo./day/yr. 18 ft. below land surface Date 9-16-77
						12. Pumping level below land surfaces: 18 ft. after 1 hrs. pumping 15 g.p.m. <input type="checkbox"/> ft. after <input type="checkbox"/> hrs. pumping <input type="checkbox"/> g.p.m. Estimated maximum yield 60+ g.p.m.
						13. Water sample submitted: <input type="checkbox"/> mo./day/yr. Yes <input checked="" type="checkbox"/> No <input type="checkbox"/> Date <input type="checkbox"/>
						14. Well head completion: <input checked="" type="checkbox"/> Pitless adapter <input type="checkbox"/> inches above grade
						15. Well grouted? YES With: <input checked="" type="checkbox"/> Neat cement <input type="checkbox"/> Bentonite <input type="checkbox"/> Concrete Depth: From 0 ft. to 10 ft.
						16. Nearest source of possible contamination: ft. 60 Direction N Type SEPTIC Well disinfected upon completion? <input checked="" type="checkbox"/> Yes <input type="checkbox"/> No
						17. Pump: <input type="checkbox"/> Not installed Manufacturer's name DAVID Model number DA5051 HP 1 Volts 110 Length of drop pipe 35 ft. capacity 15 g.p.m. Type: <input checked="" type="checkbox"/> Submersible <input type="checkbox"/> Turbine <input type="checkbox"/> Jet <input type="checkbox"/> Reciprocating <input type="checkbox"/> Centrifugal <input type="checkbox"/> Other
						20. Water well contractor's certification: This well was drilled under my jurisdiction and this report is true to the best of my knowledge and belief. 2157 Electric Co. 129 Business name 512 W. 2157 License No. Address J. Hanks Date 9-20-77 Signed <input type="checkbox"/> Authorized representative
18. Elevation:		19. Remarks:				
Topography: <input type="checkbox"/> Hill <input type="checkbox"/> Slope <input type="checkbox"/> Upland <input checked="" type="checkbox"/> Valley		CUSTOMER to pour concrete to SIAB - Signature on file				

Forward the white, blue and pink copies to the Department of Health and Environment

Form WWC-3