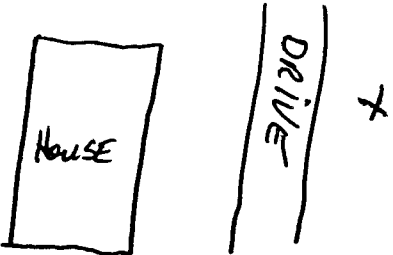


USE TYPEWRITER OR BALL
POINT PEN-PRESS FIRMLY,
PRINT CLEARLY.

WATER WELL RECORD
KSA 82a-1201-1215

Kansas Department of Health and
Environment-Division of Environment
(Water well Contractors)
Topeka, Kansas 66620

1. Location of well: County SEDBWICK		Fraction SW 1/4 NW 1/4 NW 1/4	Section number 6	Township number T 26	Range number S R 1E	E/W
2. Distance and direction from nearest town or city: Street address of well location if in city: 7610 N. MERIDIAN			3. Owner of well: RAYMOND BOTTS R.R. or street: 7610 N. MERIDIAN City, state, zip code: VALLEY CENTER, KS.			
4. Locate with "X" in section below: N W E S 1 Mile 1 Mile		Sketch map: 		6. Bore hole dia. 11 in. Completion date 10-25-77 Well depth 30 ft.		
5. Type and color of material		From	To	7. Cable tool <input checked="" type="checkbox"/> Rotary <input type="checkbox"/> Driven <input type="checkbox"/> Dug <input type="checkbox"/> Hollow rod <input type="checkbox"/> Jetted <input type="checkbox"/> Bored <input type="checkbox"/> Reverse rotary		
TOPSOIL		0	9	8. Use: <input checked="" type="checkbox"/> Domestic <input type="checkbox"/> Public supply <input type="checkbox"/> Industry <input type="checkbox"/> Irrigation <input type="checkbox"/> Air conditioning <input type="checkbox"/> Stock <input type="checkbox"/> Lawn <input type="checkbox"/> Oil field water <input type="checkbox"/> Other		
SAND - FINE		9	15	9. Casing: Material Steel Height: Above or below Threaded <input type="checkbox"/> Welded <input checked="" type="checkbox"/> Surface 12 in. RMP <input type="checkbox"/> PVC <input type="checkbox"/> Weight 1.5 lbs./ft. Dia. 5 in. to 30 ft. depth Wall Thickness: inches or Dia. <input type="checkbox"/> in. to <input type="checkbox"/> ft. depth gage No. 1200		
GRAVEL - COARSE		16	30	10. Screen: Manufacturer's name 882 Type 100 Dia. 5" Slot/gauze .065 Length 30' Set between 25 ft. and 30 ft. ft. and <input type="checkbox"/> ft. Gravel pack? YES Size range of material 1/8 - 3/8"		
				11. Static water level: <input type="checkbox"/> mo./day/yr. 15 ft. below land surface Date 10-25-77		
				12. Pumping level below land surfaces: 15 ft. after 1 hrs. pumping 15 g.p.m. ft. after <input type="checkbox"/> hrs. pumping <input type="checkbox"/> g.p.m. Estimated maximum yield 50 g.p.m.		
				13. Water sample submitted: <input type="checkbox"/> Yes <input checked="" type="checkbox"/> No Date <input type="checkbox"/>		
				14. Well head completion: <input checked="" type="checkbox"/> Pitless adapter <input type="checkbox"/> Inches above grade		
				15. Well grouted? YES With: <input checked="" type="checkbox"/> Neat cement <input type="checkbox"/> Bentonite <input type="checkbox"/> Concrete Depth: From 0 ft. to 10 ft.		
				16. Nearest source of possible contamination: ft. 100 Direction E Type SEPTIC Well disinfected upon completion? <input checked="" type="checkbox"/> Yes <input type="checkbox"/> No		
				17. Pump: <input type="checkbox"/> Not installed Manufacturer's name DANFOSSE Model number DAS052 HP 1 Volts 230 Length of drop pipe 25 ft. capacity 15 g.p.m. Type: <input checked="" type="checkbox"/> Submersible <input type="checkbox"/> Turbine <input type="checkbox"/> Jet <input type="checkbox"/> Reciprocating <input type="checkbox"/> Centrifugal <input type="checkbox"/> Other		
18. Elevation:		(Use a second sheet if needed)		20. Water well contractor's certification: This well was drilled under my jurisdiction and this report is true to the best of my knowledge and belief. 21ST Electric 129 Business name License No. Address 512 W. 21ST Signed J. HANCO Date 10-26-77 Authorized representative		
19. Remarks: CUSTOMER AGREES TO PAUL CONCRETE - SIGNATURE ON FILE. THIS IS THE SECOND WELL DRILLED FOR THIS CUSTOMER IN 30 DAYS.						

Forward the white, blue and pink copies to the Department of Health and Environment

Form WWC-5