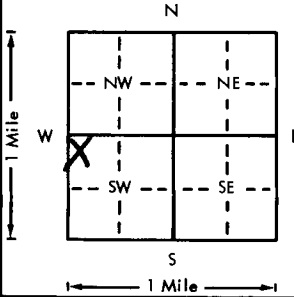
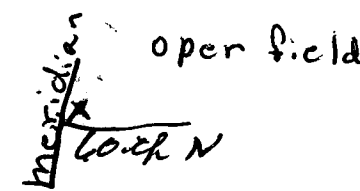


USE TYPEWRITER OR BALL
POINT PEN-PRESS FIRMLY,
PRINT CLEARLY.

WATER WELL RECORD
KSA 82a-1201-1215

Kansas Department of Health and
Environment-Division of Environment
(Water well Contractors)
Topeka, Kansas 66620

1. Location of well:		County	Fraction	Section number	Township number	Range number
		Sedgwick	NW 1/4 NW 1/4 SW 1/4	7	T 26 S	R 1 E
2. Distance and direction from nearest town or city:		3. Owner of well:				
Street address of well location if in city:		City, state, zip code:				
4. Locate with "X" in section below:		Sketch map:				
						
5. Type and color of material		From	To	6. Bore hole dia. in. Completion date		
Brown Sand		0	16	Well depth 30 ft.		
White & Brown Sand		16	30	7. Cable tool <input checked="" type="checkbox"/> Rotary <input type="checkbox"/> Driven <input type="checkbox"/> Dug		
				<input type="checkbox"/> Hollow rod <input type="checkbox"/> Jetted <input type="checkbox"/> Bored <input type="checkbox"/> Reverse rotary		
				8. Use: <input checked="" type="checkbox"/> Domestic <input type="checkbox"/> Public supply <input type="checkbox"/> Industry		
				<input type="checkbox"/> Irrigation <input type="checkbox"/> Air conditioning <input type="checkbox"/> Stock		
				<input type="checkbox"/> Lawn <input type="checkbox"/> Oil field water <input type="checkbox"/> Other		
				9. Casing: Material <u>styrorene</u> Height: <u>Above</u> or below		
				Threaded <input type="checkbox"/> Welded <input type="checkbox"/> Surface <u>12</u> in.		
				RMP <input checked="" type="checkbox"/> PVC <input type="checkbox"/> Weight <u>100</u> lbs./ft.		
				Dia. <u>4</u> in. to <u>30</u> ft. depth Wall Thickness: inches or		
				Dia. <u>4</u> in. to <u>30</u> ft. depth Gauge No. <u>100</u>		
				10. Screen: Manufacturer's name <u>Sunflow</u>		
				Type <u>100</u> Dia. <u>4</u>		
				Slot/gauze <u>5/16</u> Length <u>30</u>		
				Set between <u>30</u> ft. and <u>25</u> ft.		
				<u>ft.</u> and <u>ft.</u>		
				Gravel pack? <input checked="" type="checkbox"/> Size range of material <u>1/4"</u>		
				11. Static water level: <u>16</u> ft. below land surface Date <u>9/28/77</u>		
				12. Pumping level below land surfaces:		
				<u>ft.</u> after <u>hrs.</u> pumping <u>g.p.m.</u>		
				<u>ft.</u> after <u>hrs.</u> pumping <u>g.p.m.</u>		
				Estimated maximum yield <u>5</u> g.p.m.		
				13. Water sample submitted: <u>Yes</u> <input checked="" type="checkbox"/> No <input type="checkbox"/> Date <u>9/28/77</u>		
				14. Well head completion: <u>12</u> inches above grade		
				Pitless adapter <u>12</u> inches above grade		
				15. Well grouted? <u>yes</u>		
				With: <input checked="" type="checkbox"/> Neat cement <input type="checkbox"/> Bentonite <input type="checkbox"/> Concrete		
				Depth: From <u>0</u> ft. to <u>10</u> ft.		
				16. Nearest source of possible contamination: <u>sewer</u>		
				ft. <u>100</u> Direction <u>W</u> Type <u>sewer</u>		
				Well disinfected upon completion? <input checked="" type="checkbox"/> Yes <input type="checkbox"/> No		
				17. Pump: <input checked="" type="checkbox"/> Not installed		
				Manufacturer's name <u>Jet Drilling</u>		
				Model number <u>313</u> HP <u>1</u> Volts <u>115</u>		
				Length of drop pipe <u>25</u> ft. capacity <u>g.p.m.</u>		
				Type: <input type="checkbox"/> Submersible <input type="checkbox"/> Turbine		
				<input type="checkbox"/> Jet <input type="checkbox"/> Reciprocating		
				<input type="checkbox"/> Centrifugal <input type="checkbox"/> Other		
18. Elevation:		19. Remarks:		20. Water well contractor's certification:		
Topography: <input type="checkbox"/> Hill <input type="checkbox"/> Slope <input type="checkbox"/> Upland <input checked="" type="checkbox"/> Valley				This well was drilled under my jurisdiction and this report is true to the best of my knowledge and belief.		
				Business name <u>Jet Drilling</u> License No. <u>313</u>		
				Address <u>252 N. Sabin</u>		
				Signed <u>Walter Sabin</u> Date <u>9/28/77</u>		
				Authorized representative		

Forward the white, blue and pink copies to the Department of Health and Environment

Form WWC-5