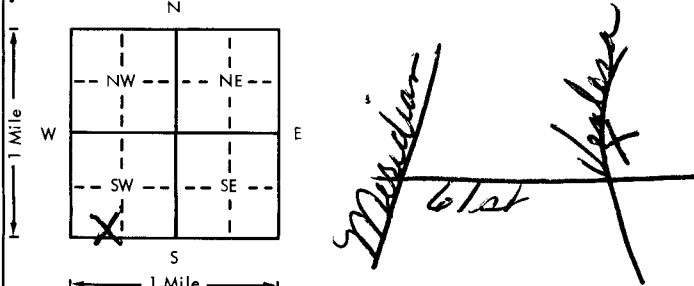


USE TYPEWRITER OR BALL
POINT PEN-PRESS FIRMLY,
PRINT CLEARLY.

WATER WELL RECORD
KSA 82a-1201-1215

Kansas Department of Health and
Environment-Division of Environment
(Water well Contractors)
Topeka, Kansas 66620

1. Location of well:		County <u>Sedgwick</u>	Fraction <u>SW 1/4 SW 1/4 SW 1/4</u>	Section number <u>7</u>	Township number <u>T 26 S</u>	Range number <u>R 1 W</u>
<input checked="" type="checkbox"/> Distance and direction from nearest town or city: <u>2 1/2 mi So</u>		3. Owner of well: <u>Jim Suttler</u>		R.R. or street: <u>6390 Ventosa</u>		
Street address of well location if in city: <u>Valley Center</u>		City, state, zip code: <u>Wichita KS 67214-79</u>				
<input checked="" type="checkbox"/> Locate with "X" in section below:		Sketch map:		6. Bore hole dia. <u>4</u> in. Completion date <u>Nov 14-79</u> Well depth <u>30</u> ft.		
				7. <input checked="" type="checkbox"/> Cable tool <input checked="" type="checkbox"/> Rotary <input type="checkbox"/> Driven <input type="checkbox"/> Dug <input type="checkbox"/> Hollow rod <input type="checkbox"/> Jetted <input type="checkbox"/> Bored <input type="checkbox"/> Reverse rotary		
5. Type and color of material		From	To	8. Use: <input checked="" type="checkbox"/> Domestic <input type="checkbox"/> Public supply <input type="checkbox"/> Industry <input type="checkbox"/> Irrigation <input type="checkbox"/> Air conditioning <input type="checkbox"/> Stock <input type="checkbox"/> Lawn <input type="checkbox"/> Oil field water <input type="checkbox"/> Other		
<u>Black Dirt</u>		<u>0</u>	<u>6</u>	9. Casing <u>Stycor</u> Height <u>(Above)</u> or below Threaded <u>Welded</u> Surface <u>12</u> in. RMP <u>PVC</u> Weight <u>1.00</u> lbs./ft. Dia. <u>4</u> in. to <u>30</u> ft. depth Wall Thickness inches or Dia. <u>1/4</u> in. to <u>1/4</u> ft. depth gage No. <u>1/4</u>		
<u>Yellow Sand</u>		<u>6</u>	<u>16</u>	<input checked="" type="checkbox"/> Screen: Manufacturer's name <u>Cesmac</u> Type <u>100</u> Dia. <u>4</u> <input checked="" type="checkbox"/> Slot/gauze <u>25</u> Length <u>30</u> Set between <u>25</u> ft. and <u>30</u> ft. <u>14</u> ft. and <u>14</u> ft. Gravel pack <u>No</u> Size range of material <u> </u>		
<u>White Sand</u>		<u>16</u>	<u>30</u>	11. Static water level: <u>15</u> ft. below land surface Date <u>Nov 14-79</u> mo./day/yr.		
				12. Pumping level below land surfaces: ____ ft. after ____ hrs. pumping ____ g.p.m. ____ ft. after ____ hrs. pumping ____ g.p.m. Estimated maximum yield <u>10</u> g.p.m.		
				13. Water sample submitted: <u>1</u> mo./day/yr. Yes <input checked="" type="checkbox"/> No <input type="checkbox"/> Date <u>Nov 14-79</u>		
				14. Well head completion: <input type="checkbox"/> Pitless adapter <u>12</u> inches above grade		
				15. Well grouted? <u>Yes</u> With: <input checked="" type="checkbox"/> Neat cement <input type="checkbox"/> Bentonite <input type="checkbox"/> Concrete Depth: From <u>0</u> ft. to <u>10</u> ft.		
				16. Nearest source of possible contamination: ft. <u>30</u> Direction <u>E</u> Type <u>sewer</u> Well disinfected upon completion? <input checked="" type="checkbox"/> Yes <input type="checkbox"/> No		
				17. Pump: <input checked="" type="checkbox"/> Not installed Manufacturer's name <u> </u> Model number <u> </u> HP <u> </u> Volts <u> </u> Length of drop pipe <u> </u> ft. capacity <u> </u> g.p.m. Type: <input type="checkbox"/> Submersible <input type="checkbox"/> Turbine <input type="checkbox"/> Jet <input type="checkbox"/> Reciprocating <input type="checkbox"/> Centrifugal <input type="checkbox"/> Other		
18. Elevation:		19. Remarks:		20. Water well contractor's certification: This well was drilled under my jurisdiction and this report is true to the best of my knowledge and belief. <u>Get Welling</u> 313A Business name <u>257 N Salun</u> License No. <u> </u> Address <u>9044 Chandler Dr</u> Signed <u> </u> Date <u>Nov 14-79</u> Authorized representative		

Forward the white, blue and pink copies to the Department of Health and Environment

Form WWC-5