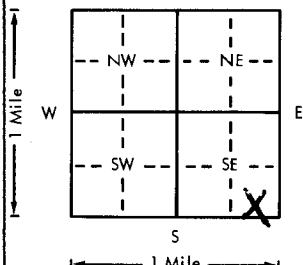
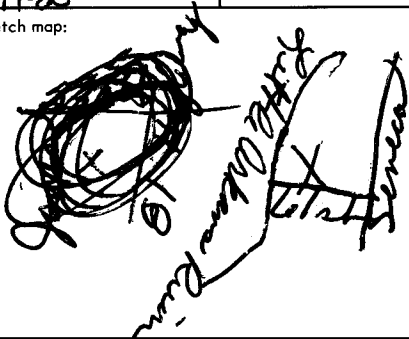


USE TYPEWRITER OR BALL
POINT PEN—PRESS FIRMLY,
PRINT CLEARLY.

WATER WELL RECORD
KSA 82a-1201-1215

Kansas Department of Health and
Environment—Division of Environment
(Water well Contractors)
Topeka, Kansas 66620

1. Location of well: <u>Sedgwick</u>		Fraction: <u>SE 1/4 SE 1/4</u>	Section number: <u>7</u>	Township number: <u>T 26 S</u>	Range number: <u>R 10 W</u>
2. Distance and direction from nearest town or city: <u>3 miles N</u>		3. Owner of well: <u>Alex Bora</u>			
Street address of well location if in city: <u>Wichita</u>		R.R. or street: <u>1420 W. 61st N</u>			
		City, state, zip code: <u>Wichita, KS 67201</u>			
4. Locate with "X" in section below:		Sketch map:		6. Bore hole dia. <u>8</u> in. Completion date <u>6/23/79</u>	
				Well depth <u>35</u> ft.	
5. Type and color of material		From	To	7. Cable tool <input checked="" type="checkbox"/> Rotary <input type="checkbox"/> Driven <input type="checkbox"/> Dug	
<u>Brown Clay</u>		<u>0</u>	<u>9</u>	<input type="checkbox"/> Hollow rod <input type="checkbox"/> Jetted <input type="checkbox"/> Bored <input type="checkbox"/> Reverse rotary	
<u>Brown Sand</u>		<u>9</u>	<u>25</u>	8. Use: <input checked="" type="checkbox"/> Domestic <input type="checkbox"/> Public supply <input type="checkbox"/> Industry	
<u>White Coarse Gravel</u>		<u>25</u>	<u>35</u>	<input type="checkbox"/> Irrigation <input type="checkbox"/> Air conditioning <input type="checkbox"/> Stock	
				<input type="checkbox"/> Lawn <input type="checkbox"/> Oil field water <input type="checkbox"/> Other	
				9. Casing: <u>Styrene</u> Height: Above or below	
				Threaded <input type="checkbox"/> Welded <input type="checkbox"/> Surface <u>12</u> in.	
				RMP <input type="checkbox"/> PVC <input checked="" type="checkbox"/> Weight <u>100</u> lbs./ft.	
				Dia. <u>4</u> in. to <u>35</u> ft. depth Wall Thickness: inches of	
				Dia. <u>4</u> in. to <u>35</u> ft. depth Gauge No. <u>10014</u>	
				10. Screen: Manufacturer's name <u>Sumflow</u>	
				Type <u>100</u> Dia. <u>4</u>	
				Slot/gauze <u>Slot</u> Length <u>35</u>	
				Set between <u>30</u> ft. and <u>35</u> ft.	
				Gravel pack? <u>No</u> Size range of material	
				11. Static water level: <u>10</u> ft. below land surface Date <u>6/23/79</u>	
				12. Pumping level below land surfaces:	
				<u>10</u> ft. after <u>5</u> hrs. pumping <u>5</u> g.p.m.	
				<u>10</u> ft. after <u>5</u> hrs. pumping <u>5</u> g.p.m.	
				Estimated maximum yield <u>5</u> g.p.m.	
				13. Water sample submitted: <u>No</u> Date	
				14. Well head completion: <u>12</u> inches above grade	
				15. Well grouted? <u>Yes</u>	
				With: <u>Neat cement</u> <input type="checkbox"/> Bentonite <input type="checkbox"/> Concrete <input type="checkbox"/>	
				Depth: From <u>0</u> ft. to <u>10</u> ft.	
				16. Nearest source of possible contamination: <u>50</u> ft. Direction <u>N</u> Type <u>sewer</u>	
				Well disinfected upon completion? <input checked="" type="checkbox"/> Yes <input type="checkbox"/> No	
				17. Pump: <u>Not installed</u>	
				Manufacturer's name	
				Model number HP Valts	
				Length of drop pipe ft. capacity g.p.m.	
				Type:	
				<input type="checkbox"/> Submersible <input type="checkbox"/> Turbine	
				<input type="checkbox"/> Jet <input type="checkbox"/> Reciprocating	
				<input type="checkbox"/> Centrifugal <input type="checkbox"/> Other	
18. Elevation:		19. Remarks:			
Topography: <input checked="" type="checkbox"/> Hill <input type="checkbox"/> Slope <input type="checkbox"/> Upland <input checked="" type="checkbox"/> Valley		(Use a second sheet if needed)			
		20. Water well contractor's certification:			
		This well was drilled under my jurisdiction and this report is true to the best of my knowledge and belief.			
		<u>Jet Drilling 313A</u>			
		Business name <u>2571 N. Salina</u> License No.			
		Address <u>Wichita, KS 67201</u>			
		Signed <u>W. A. Sandberg</u> Date <u>6/23/79</u>			
		Authorized representative			

Forward the white, blue and pink copies to the Department of Health and Environment

Form WWC-5