USE TYPEWRITER OR BALL POINT PEN-PRESS FIRMLY, PRINT CLEARLY.

WATER WELL RECORD
KSA 82a-1201-1215

Kansas Department of Health and Environment-Division of Environment
(Water well Contractors)
Topeka, Kansas 66620

1. Location of well:	County	Fraction	Section number	Township number	Range number
	Sedgwick	NW NE NW NW 1/4 1/4 1/4	18	T 26 S	R 1E E/W

2. Distance and direction from nearest town or city:
Street address of well location if in city: 2226 Ventoso Road Valley Center, Kansas

3. Owner of well: Steve Lee
R.R. or street: 2421 West 25th North
City, state, zip code: Wichita, Kansas

4. Locate with "X" in section below:

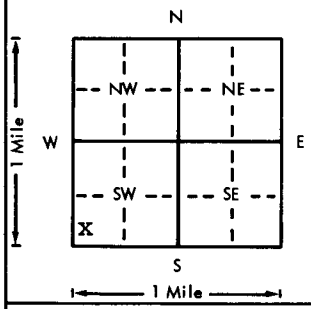

Sketch map:

6. Bore hole dia. 11 in. Completion date
Well depth 45 ft. 8-9-77

7. __ Cable tool X Rotary __ Driven __ Dug
__ Hollow rod __ Jetted __ Bored __ Reverse rotary

8. Use: X Domestic __ Public supply __ Industry
__ Irrigation __ Air conditioning __ Stock
__ Lawn __ Oil field water __ Other

9. Casing: Material Styrene
Threaded ___ Welded gl
RMP X PVC ___
Dia. 5 in. to 45 ft. depth
Dia. ___ in. to ___ ft. depth
Height: Above or below Surface 12 in.
Weight ___ lbs./ft.
Wall Thickness: inches or gage No. .200

10. Screen: Manufacturer's name Sunflower Plastic
Type Styrene Dia. 5"
Slot/gauze .06 Length 10'
Set between 35 ft. and 45 ft.
___ ft. and ___ ft.
Gravel pack? yes Size range of material ¼-1/8"

11. Static water level: mo./day/yr.
15 ft. below land surface Date 8-9-77

12. Pumping level below land surfaces:
___ ft. after ___ hrs. pumping ___ g.p.m.
___ ft. after ___ hrs. pumping ___ g.p.m.
Estimated maximum yield ___ g.p.m.

13. Water sample submitted: mo./day/yr.
___ Yes ___ No Date

14. Well head completion: Capped
___ Pitless adapter 12 Inches above grade

15. Well grouted? yes 1to2 fine sand mix.
With: ___ Neat cement ___ Bentonite X Concrete
Depth: From 6 ft. to 16 ft.

16. Nearest source of possible contamination: NONE
ft. ___ Direction ___ Type ___
Well disinfected upon completion? X Yes ___ No

17. Pump: X Not installed
Manufacturer's name
Model number ___ HP ___ Volts ___
Length of drop pipe ___ ft. capacity ___ g.p.m.
Type:
___ Submersible ___ Turbine
___ Jet ___ Reciprocating
___ Centrifugal ___ Other

5. Type and color of material	From	To
Topsoil	0	3
Fine Sand	3	25
Clay	25	28
Medium Sand	28	45

(Use a second sheet if needed)

18. Elevation:

Topography:
___ Hill
X Slope
___ Upland
___ Valley

19. Remarks: Septic System was not installed when the well was drilled.
No apparent source for contamination.
Well to be in the basement

20. Water well contractor's certification:
This well was drilled under my jurisdiction and this report is true to the best of my knowledge and belief.
Business name Harp Well & Pump License No. 236
Address Wichiata, Kansas
Signed M. Arnold Date 8-17-77
Authorized representative

T 26 R 1 E/W Sec 18 1/4 1/4 1/4 SE SW

Forward the white, blue and pink copies to the Department of Health and Environment

Form WWC-5

MI-1023